

5 cm

217-146

Published by  
J. & J. G. Jones  
1884

LONGITUDINAL SECTION




4


TRANSVERSE SECTION



4

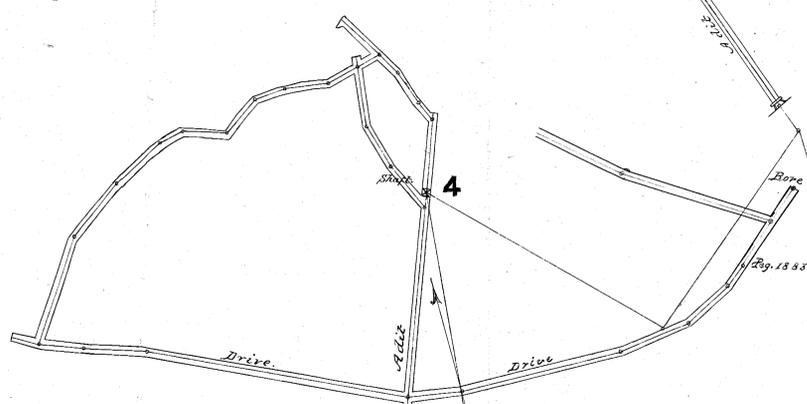

LONGITUDINAL SECTION

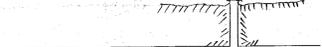

3

TRANSVERSE SECTION



3

STANHOPE COMPANY

Surveys Line



TRANSVERSE SECTION




2

# THE MOUNT BISCHOFF T. M. COMPANY'S UNDERGROUND WORKS.

Scale 50 Feet to one Inch.

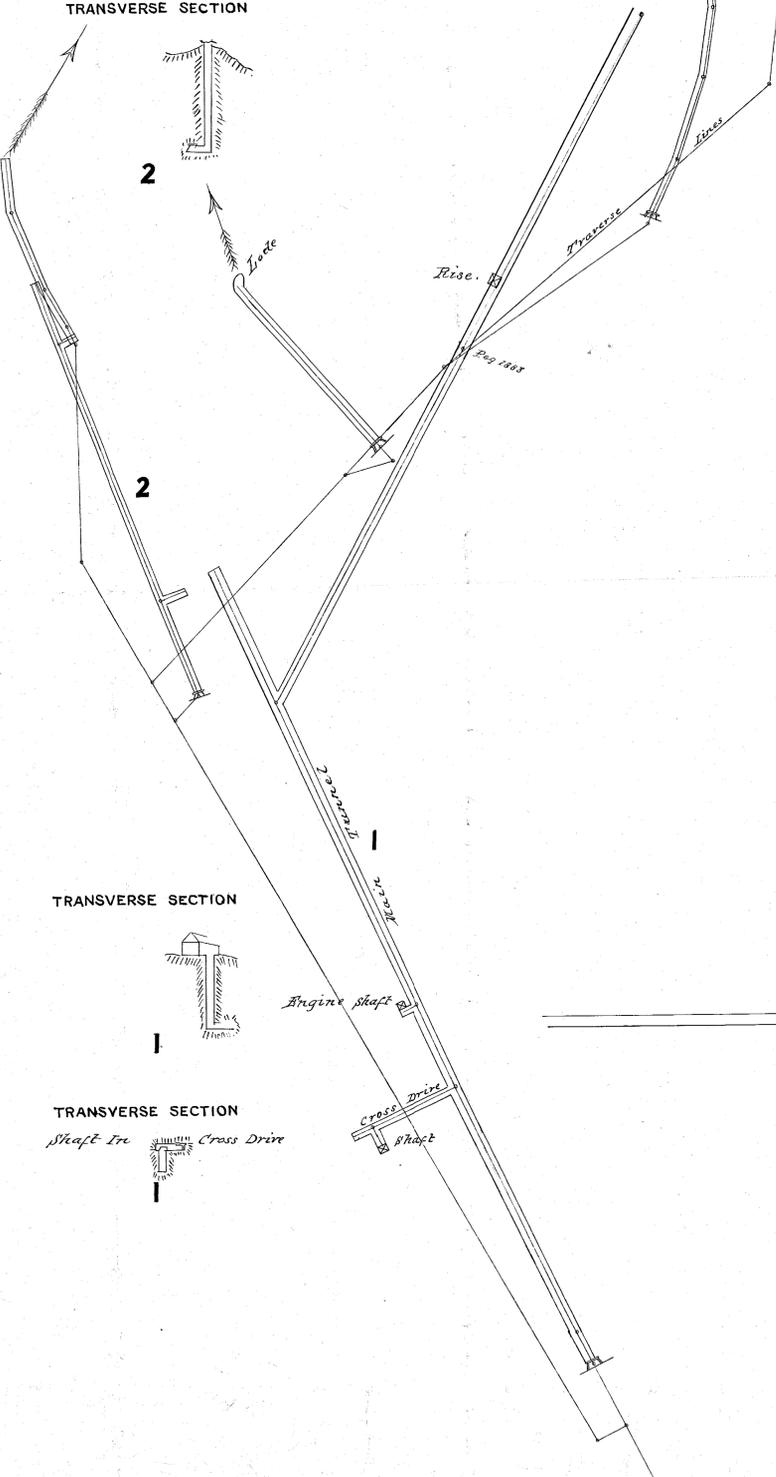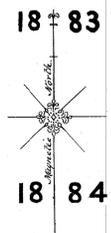


LONGITUDINAL SECTION

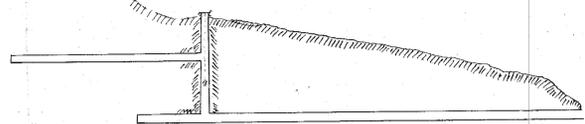

2

LONGITUDINAL SECTION

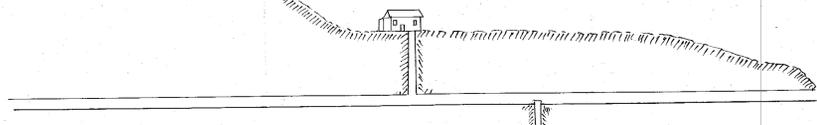

1

TRANSVERSE SECTION



1

TRANSVERSE SECTION



1

From Plan made by

David Jones

Surveyor

Warratah.

March 5<sup>th</sup> 1883.

February 1884