


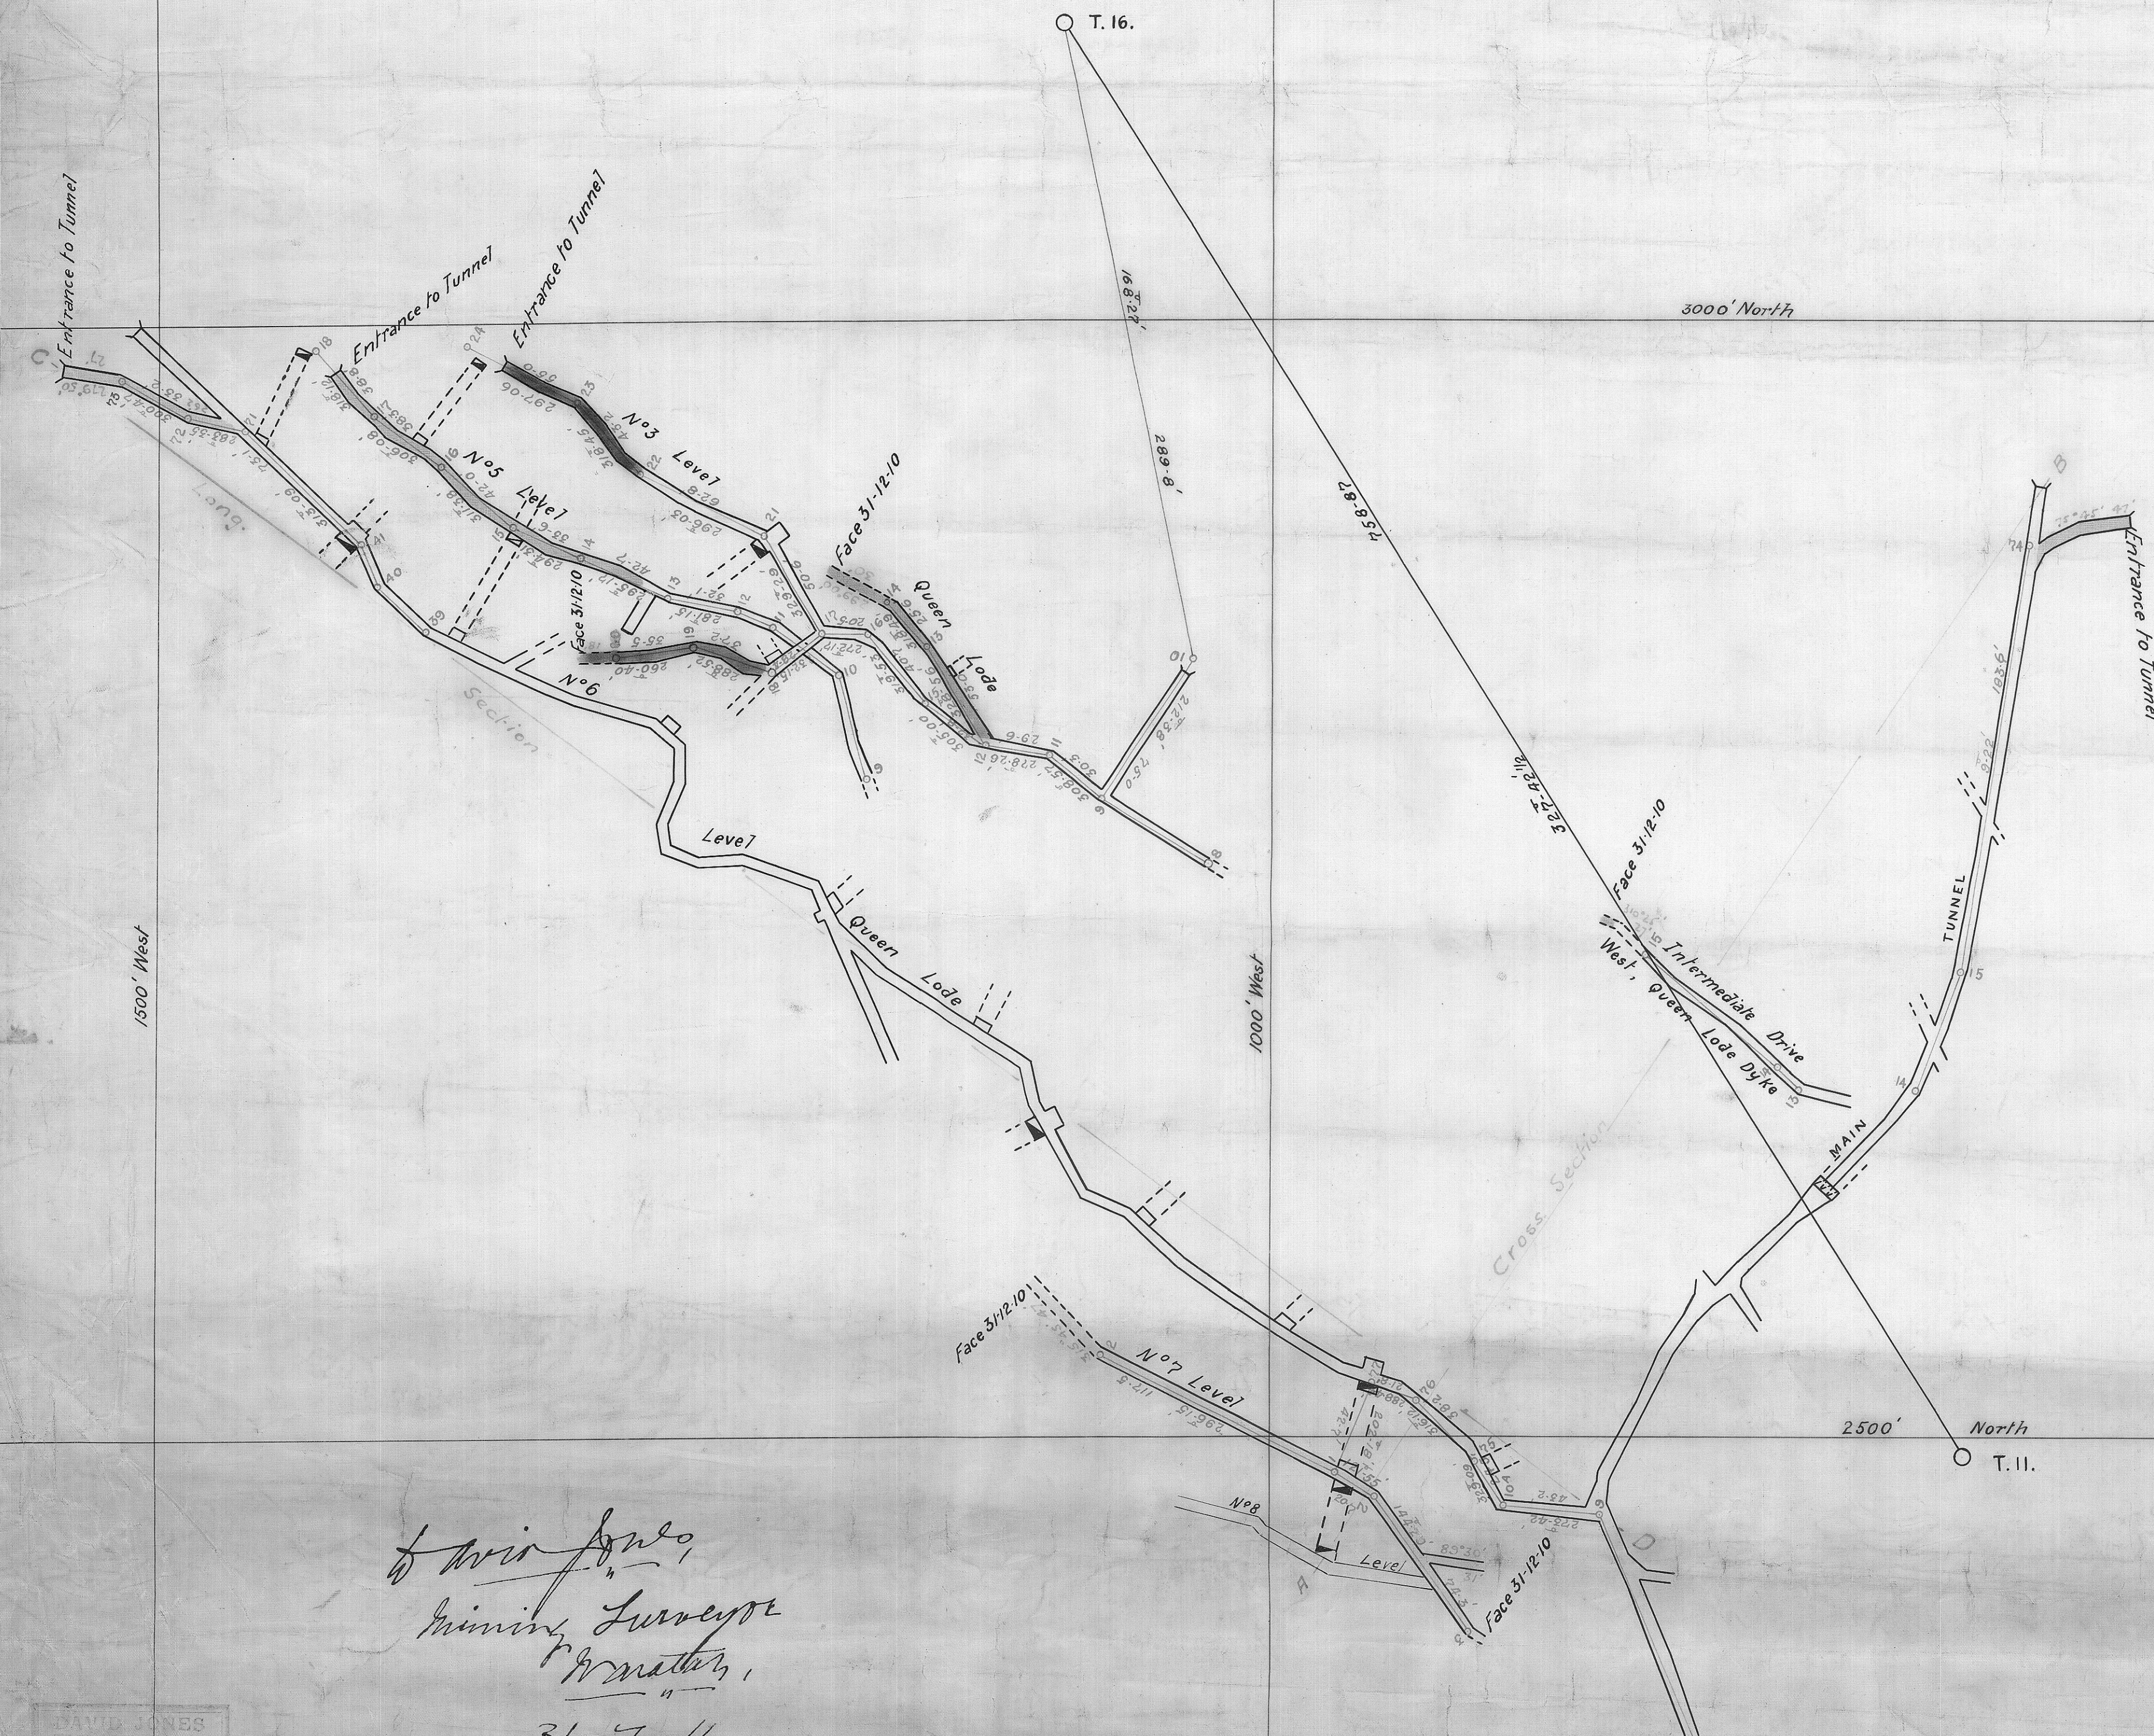

— MT BISCHOFF T M CO —
— PLAN OF UNDERGROUND WORKINGS —
— FOR YEAR 1910 —
— SCALE 50 FT TO AN INCH —

to Wm Jones,
Mining Surveyor
for matter,
31. 7. 11.

Page 31/12-10