

217-152



5 cm

M^r Biochoff Tin Mining Co Reg

Underground Workings for Year 1913

Scale 50ft = 1in



Old Stanhope Workings

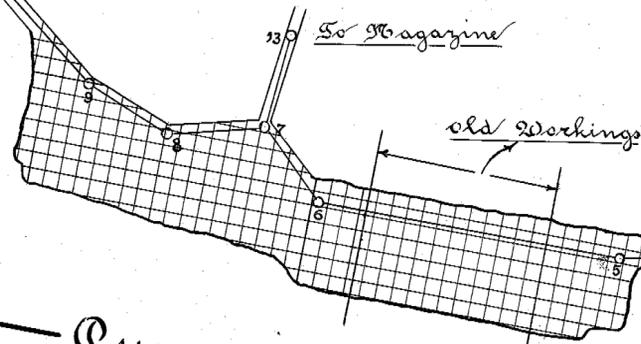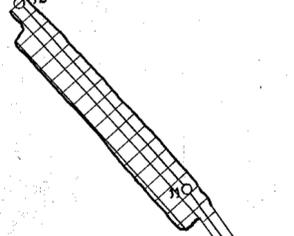

Queen Lode Dyke

2500 North

500 20 East

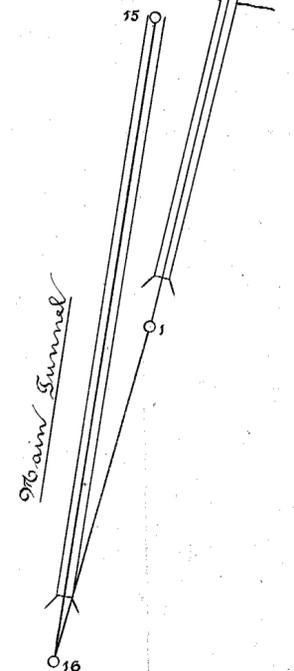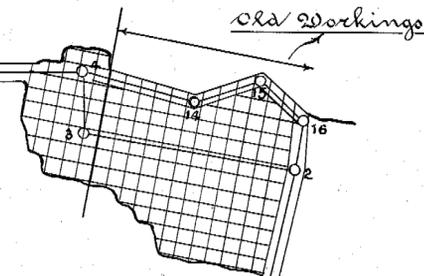

N.B. cross hatching diagrammatic and does not show position of sets

Surveyor - P.H. J. [Signature]

100 20 East

100