


217-154

5 cm

217-154

M^r Bischoff Sin Mining Co Reg. Underground Workings for Year 1911.

Scale 50 feet = 1 inch.

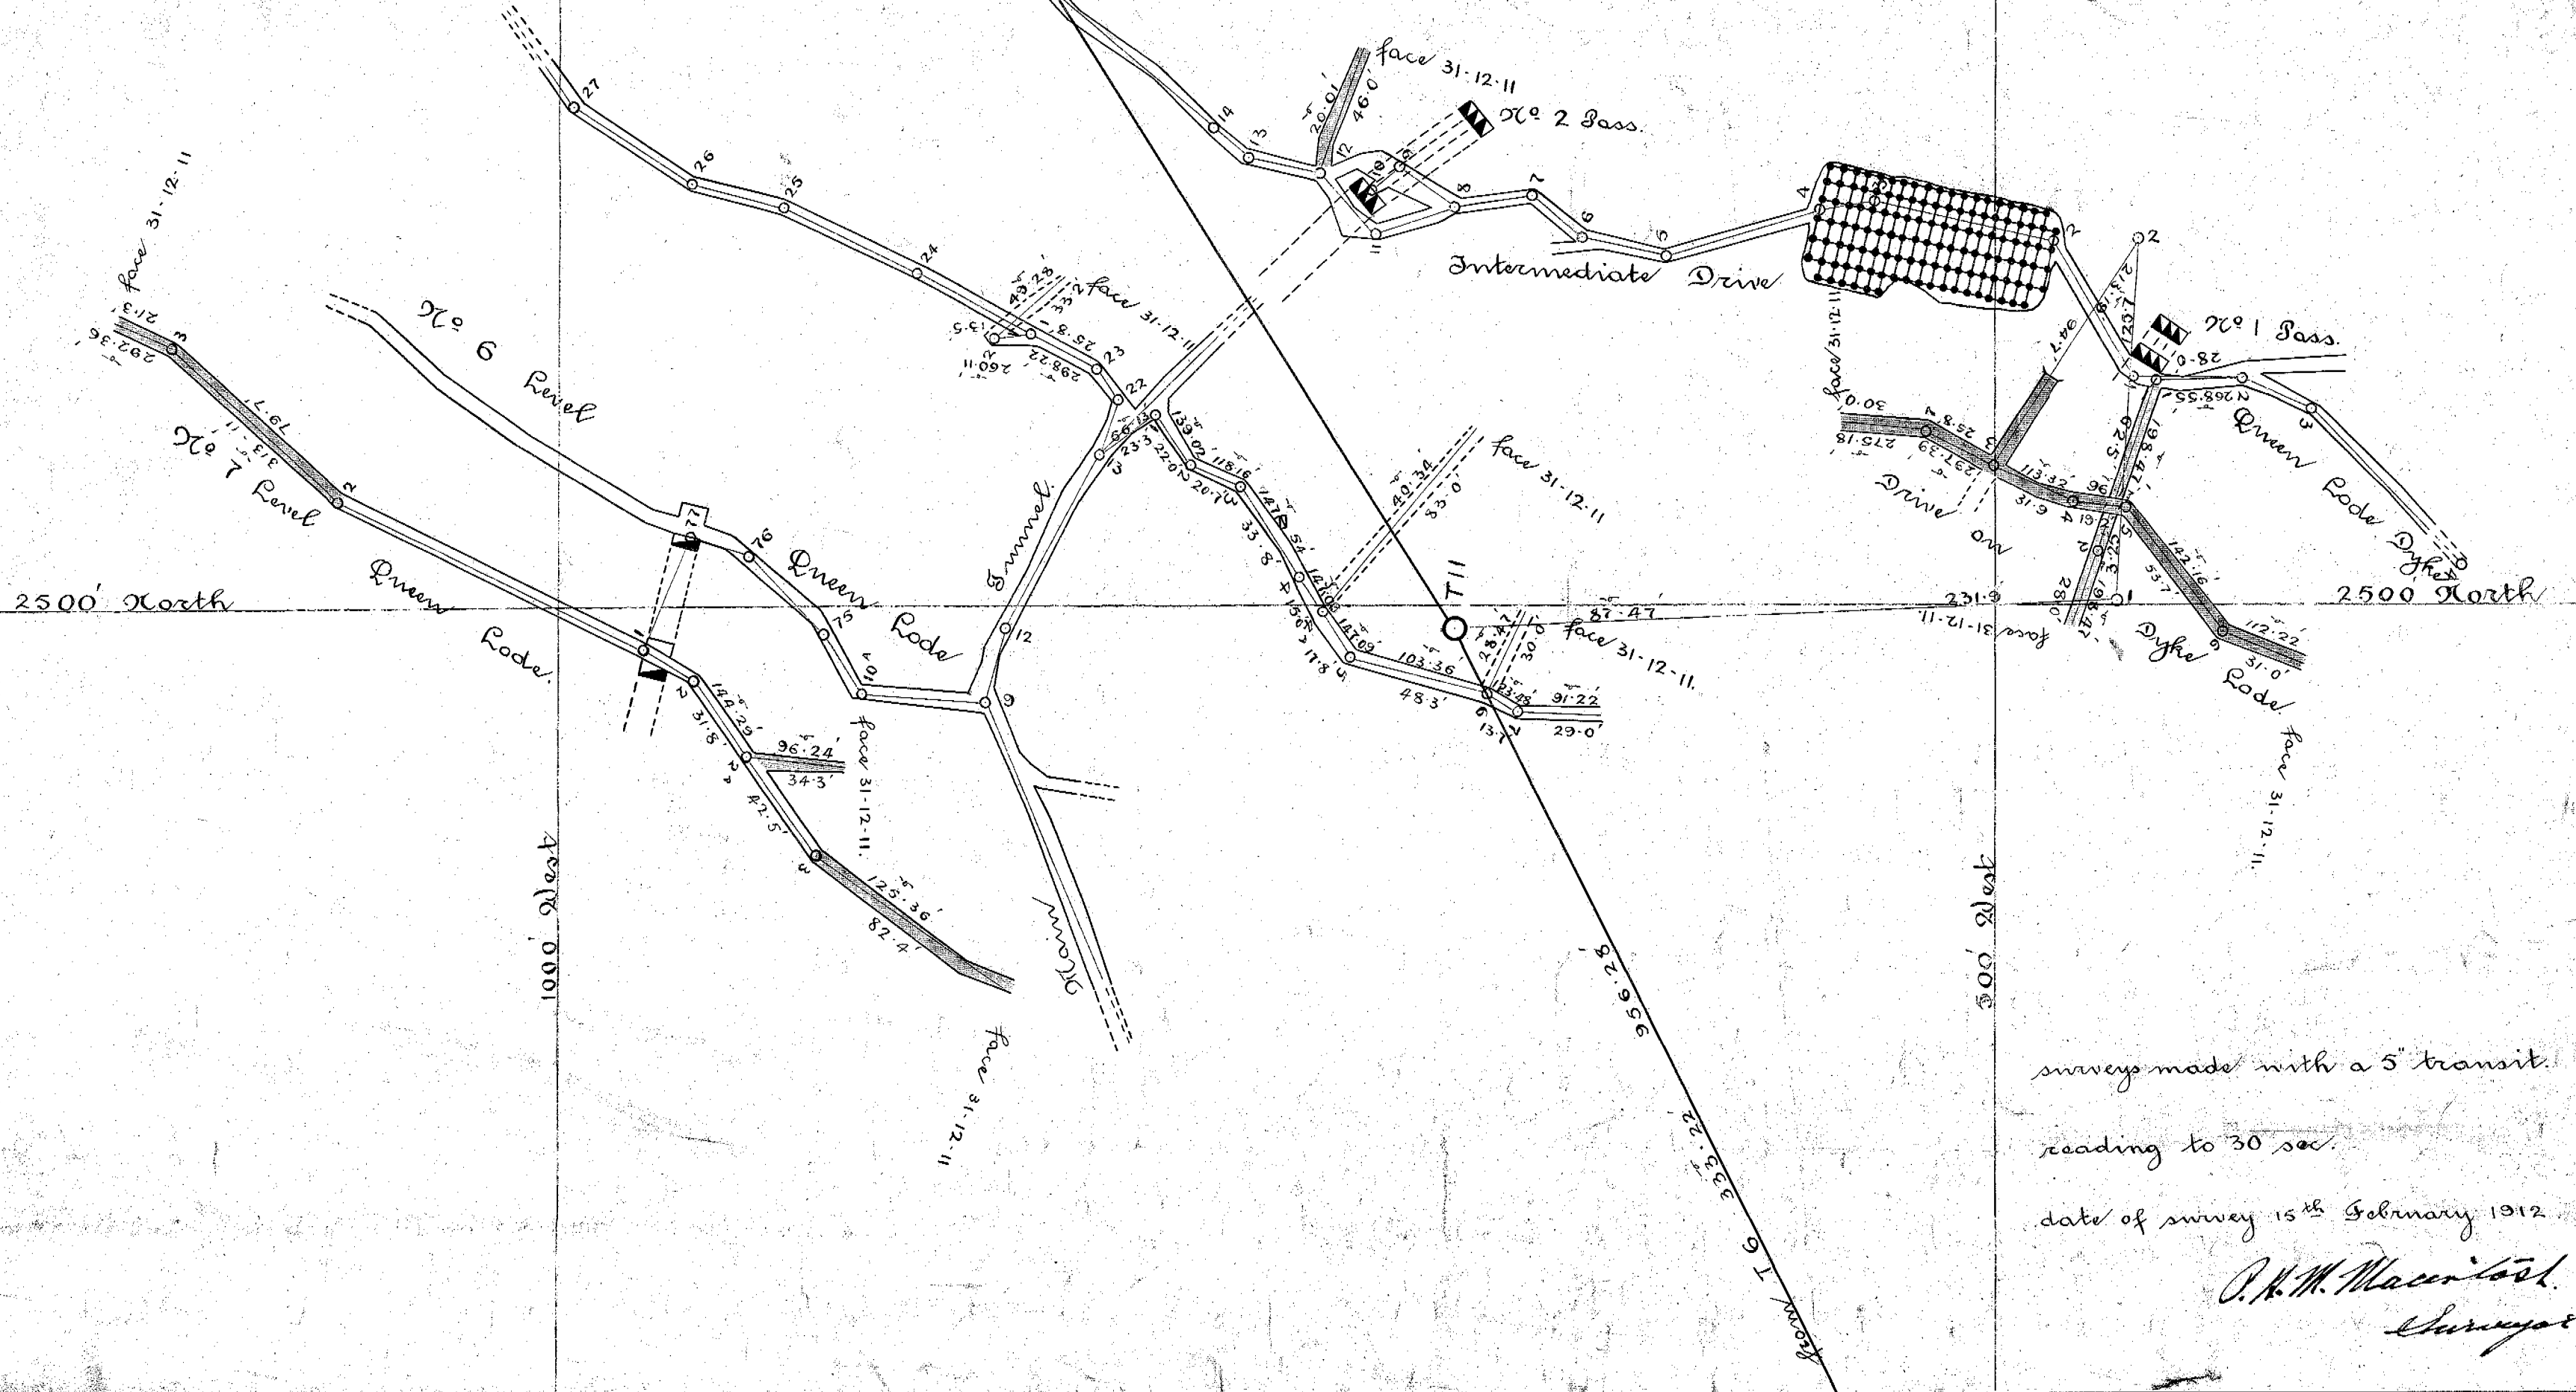

surveys made with a 5" transit.

reading to 30 sec.

date of survey 15th February 1912

P. H. M. Macintosh
 Surveyor