
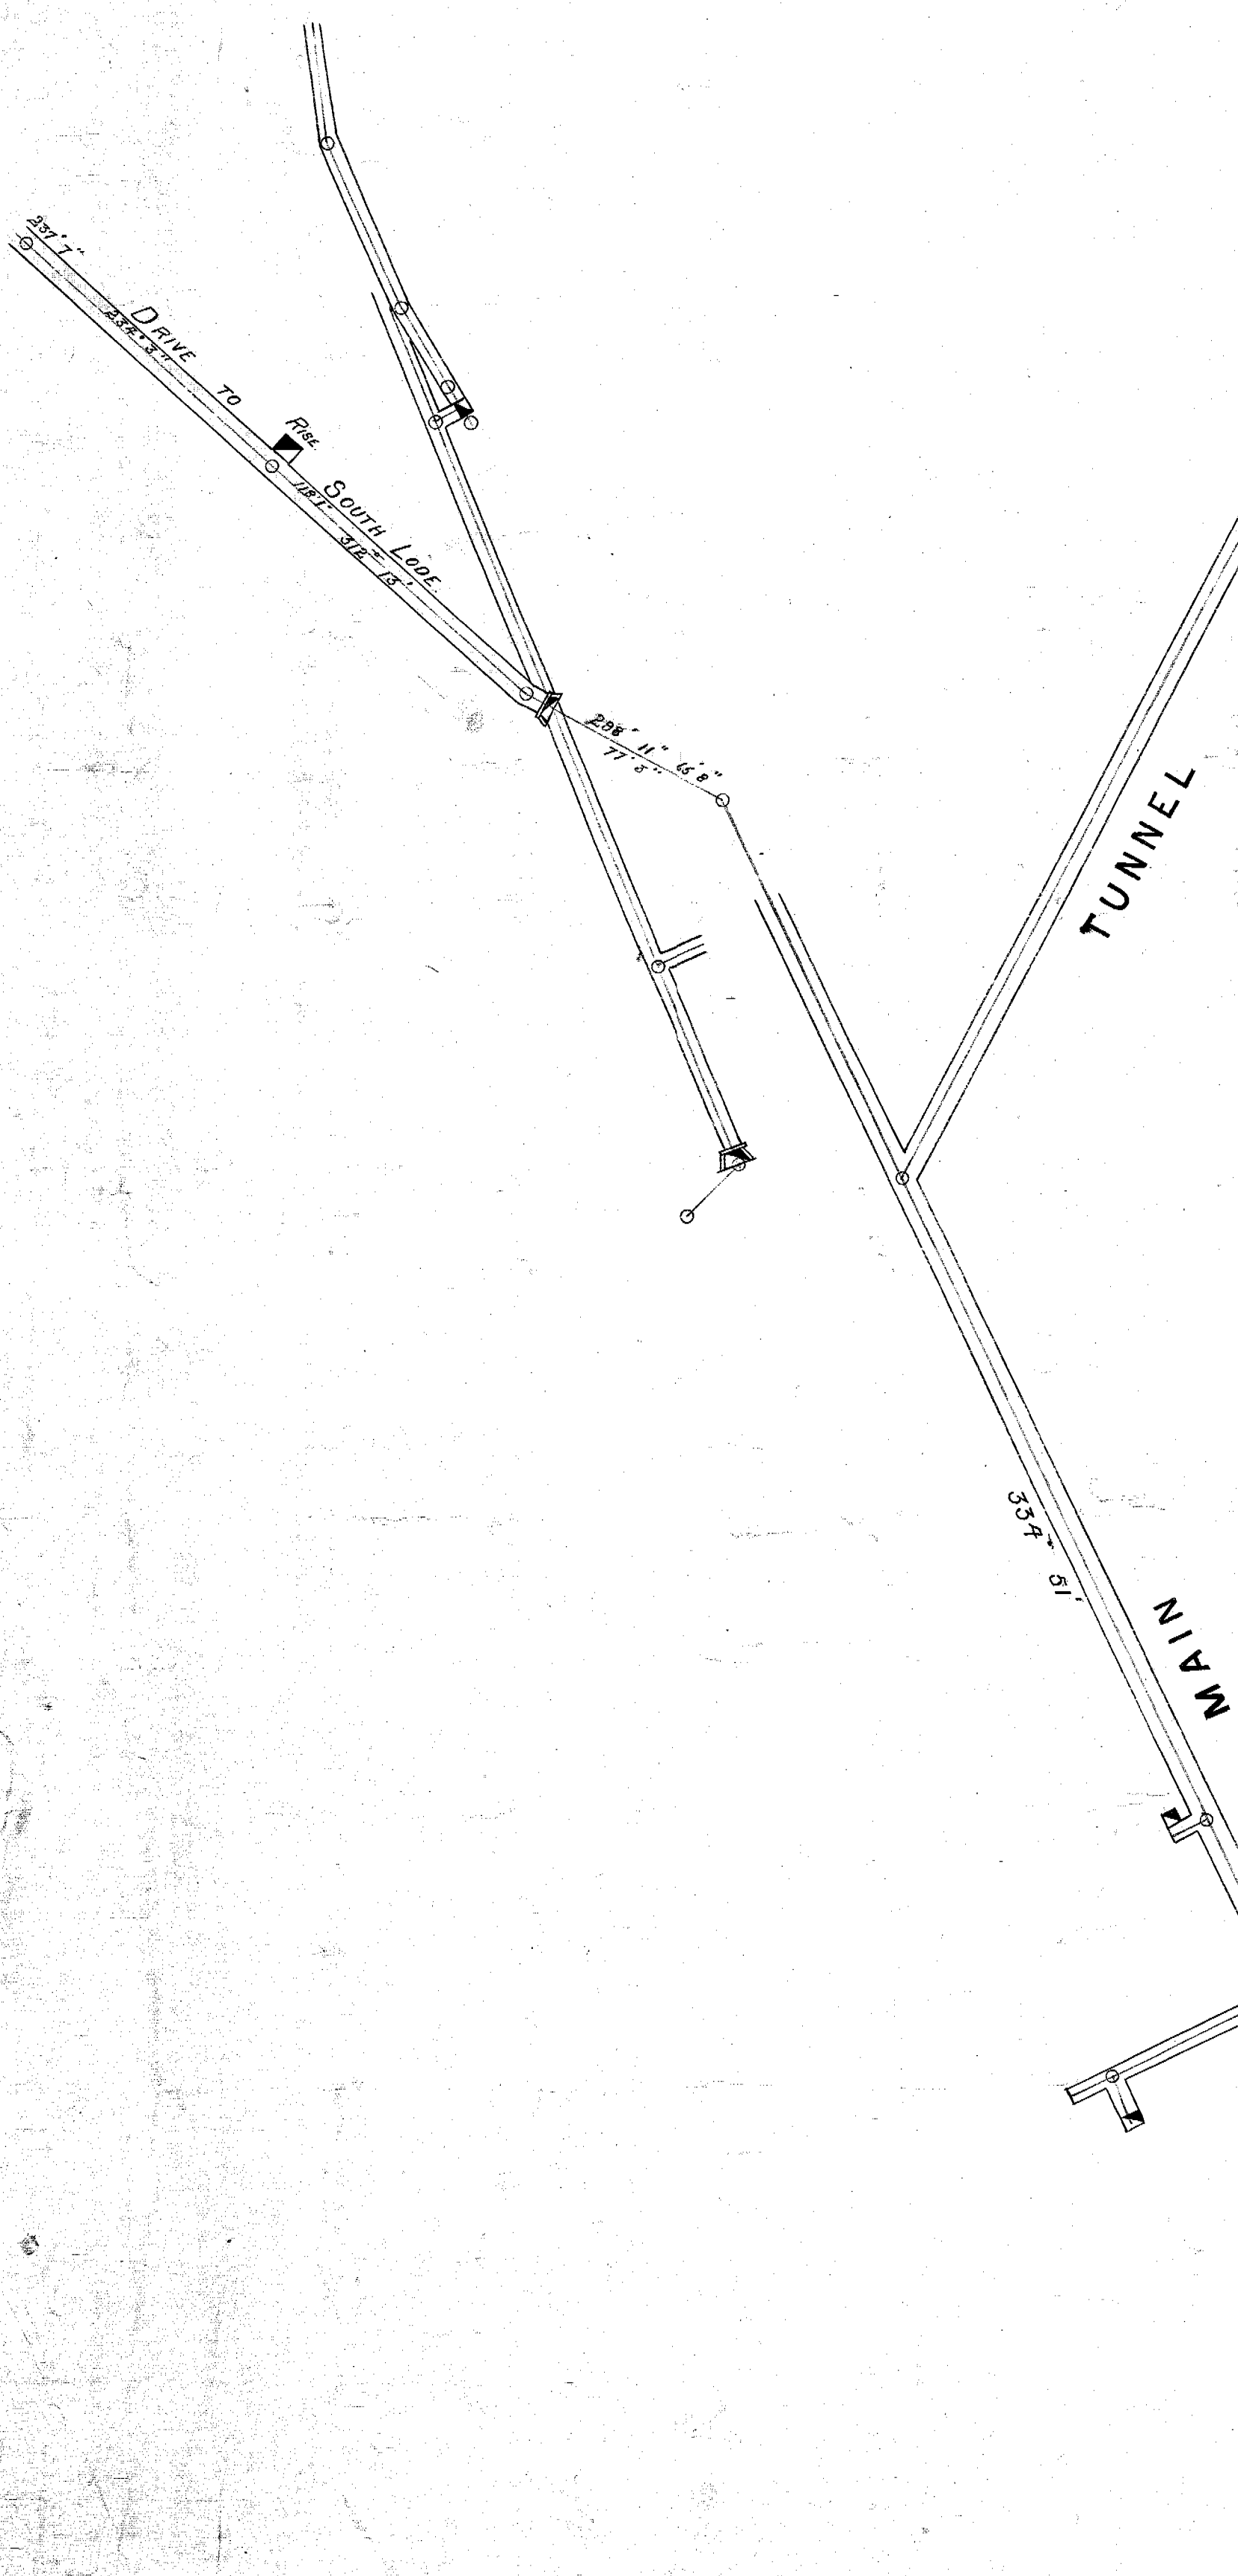
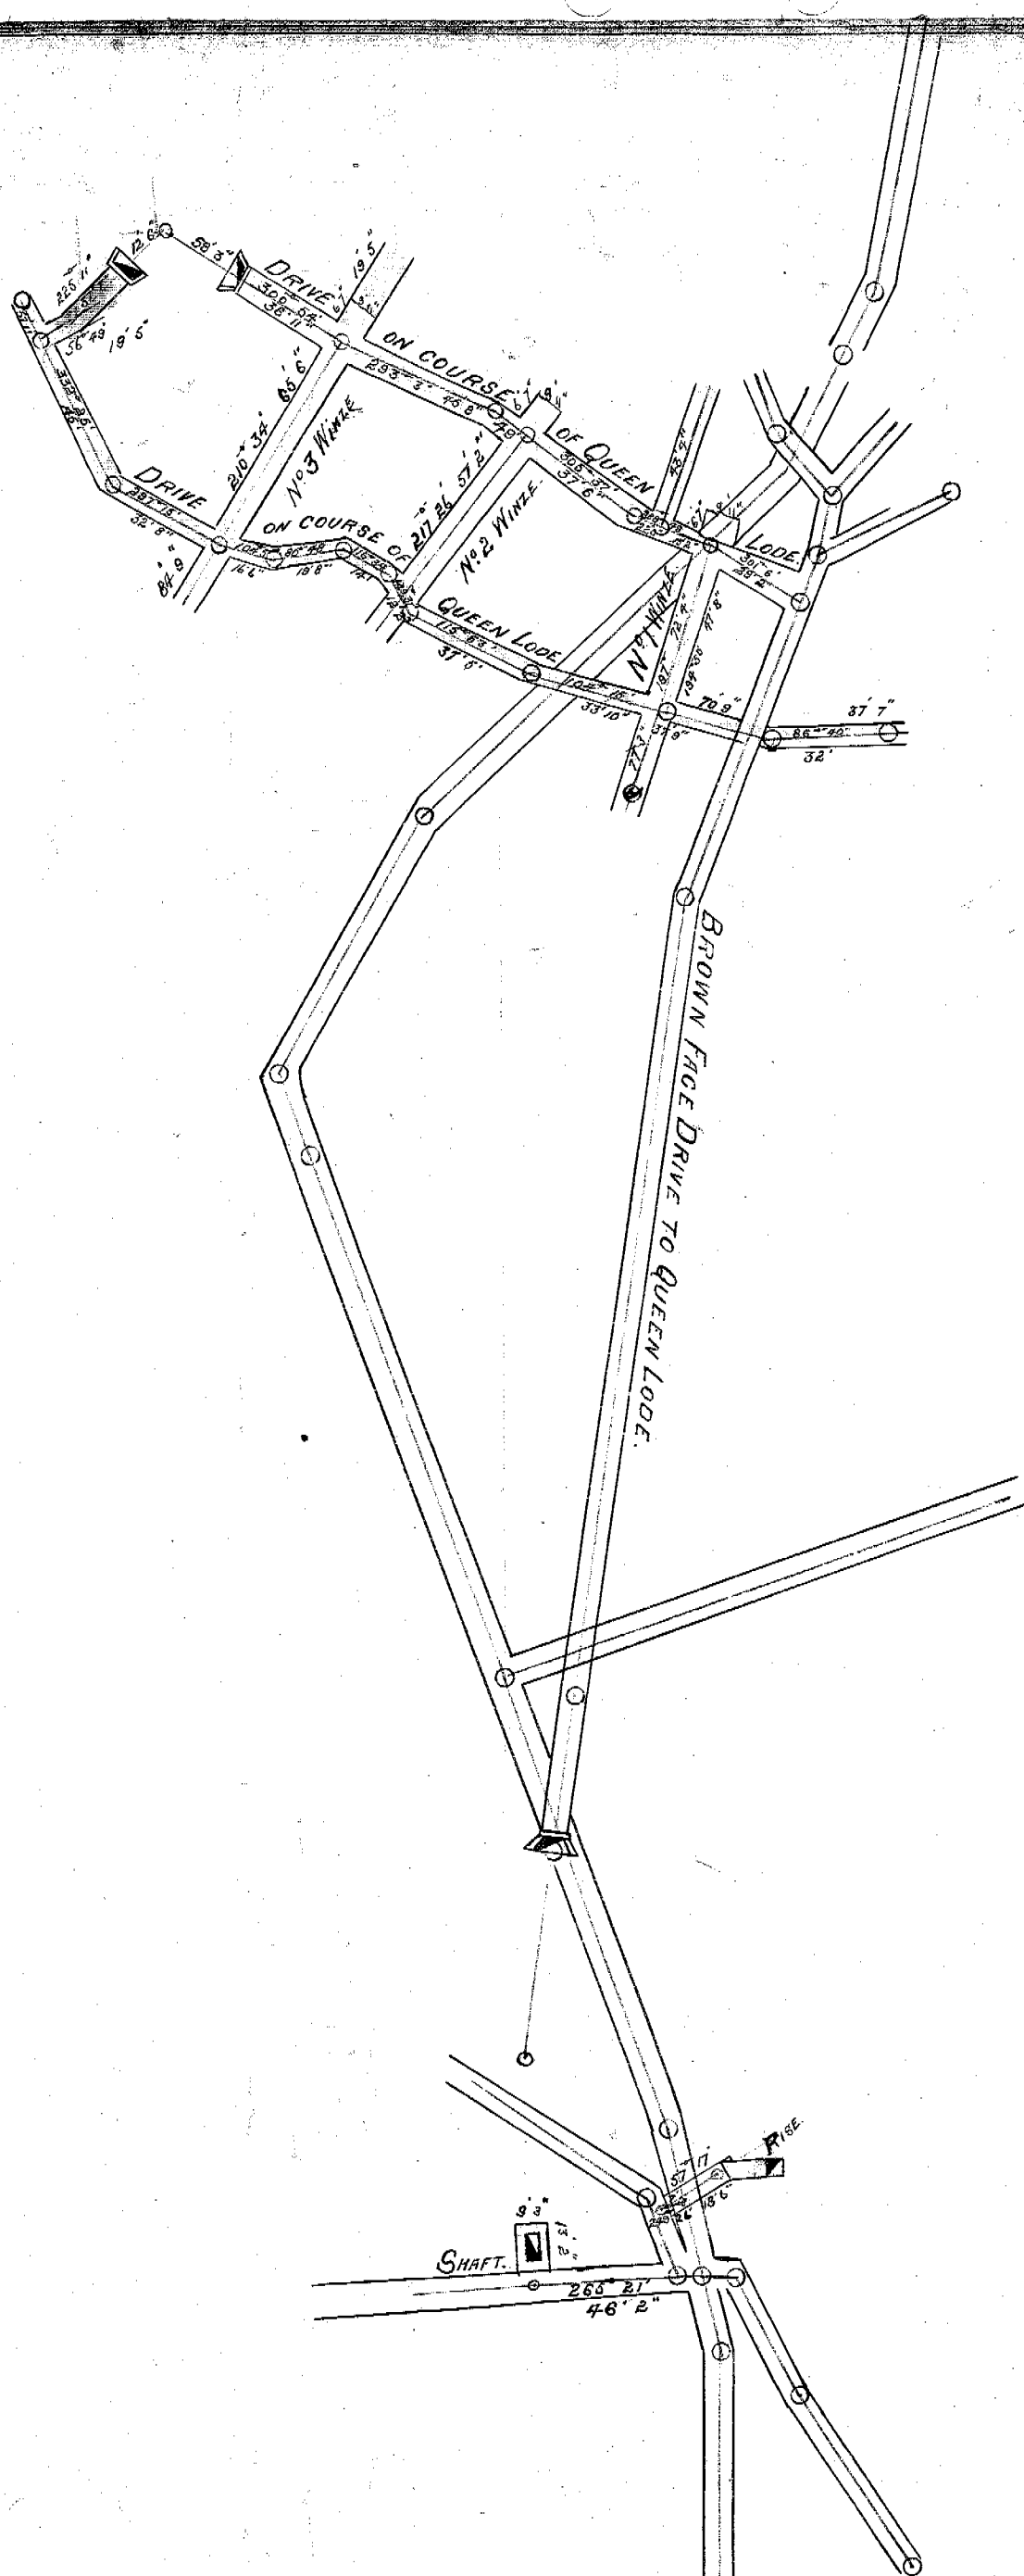


217-156

5 cm

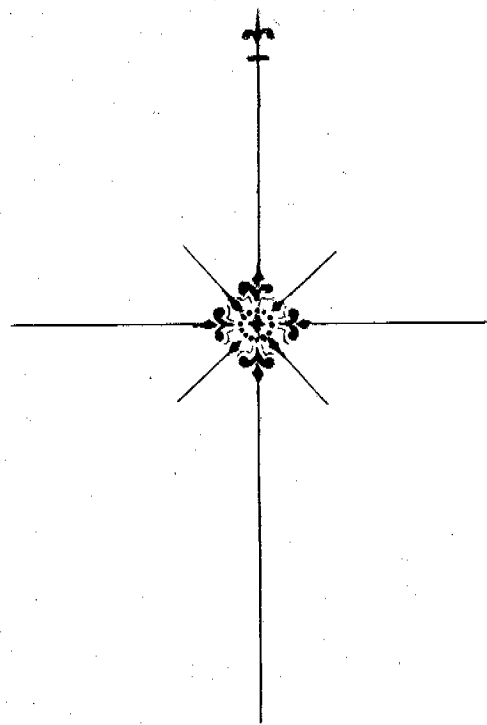

PLAN
OF
MT BISCHOFF T. M. COMPANYS.
UNDERGROUND WORKS


Scale 50 Feet to one Inch

1898

I David Jones of Waratah hereby
declare this plan to be sufficiently
correct for the purposes of the
Mines Act of 1893.

David Jones
District Surveyor

Waratah 25.2.99

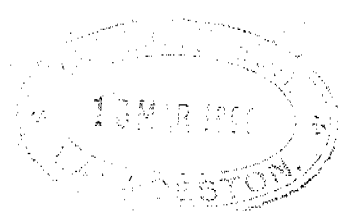

SOUTH ENTRANCE.

11th Dec 1898
David Jones

MINING PLAN