


217-161

THE M.T.
Bischoff I. M. Co's
Extension of Underground
Workings.
1891
Scale 50 ft to an Inch.

David Jones
British Mining Surveyor
1891.

217
British Mining Surveyor
1891

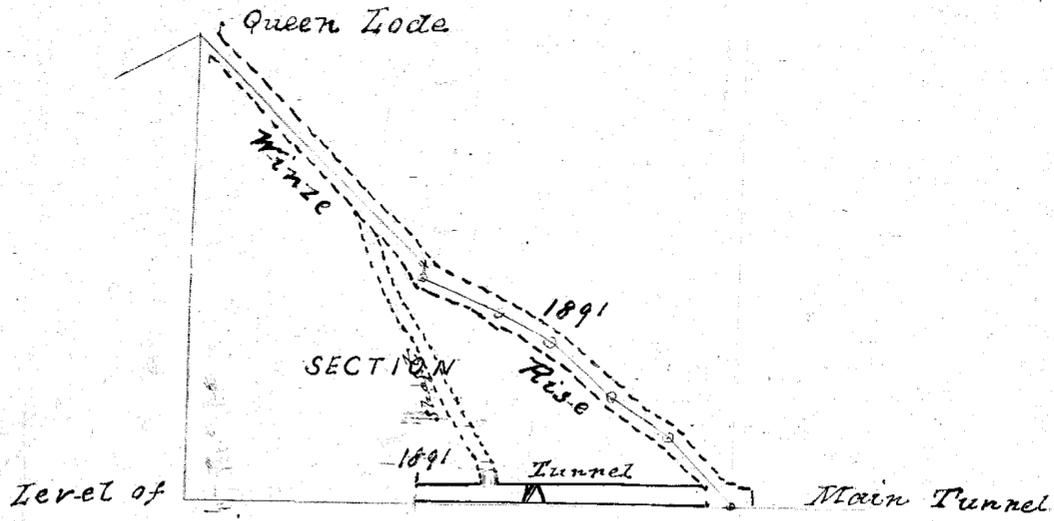

Peg 1888

M.E. Bischoff I. M. Co's
Tunnel

EASTERN CROSS CUT

Peg 1891

Drive

Rise

Peg 1891

Drive

Shaft in Tunnel

Shaft in Winze

WINZE ON QUEEN LODGE

1891

Peg 1890

ADIT THROUGH HILL

Cross Drive from
M.E. B. Co's Main Tunnel
Peg 1891

Peg

Peg Peg

1300

1889 1889

Transverse Line

Surveyed Line

1891

1891