
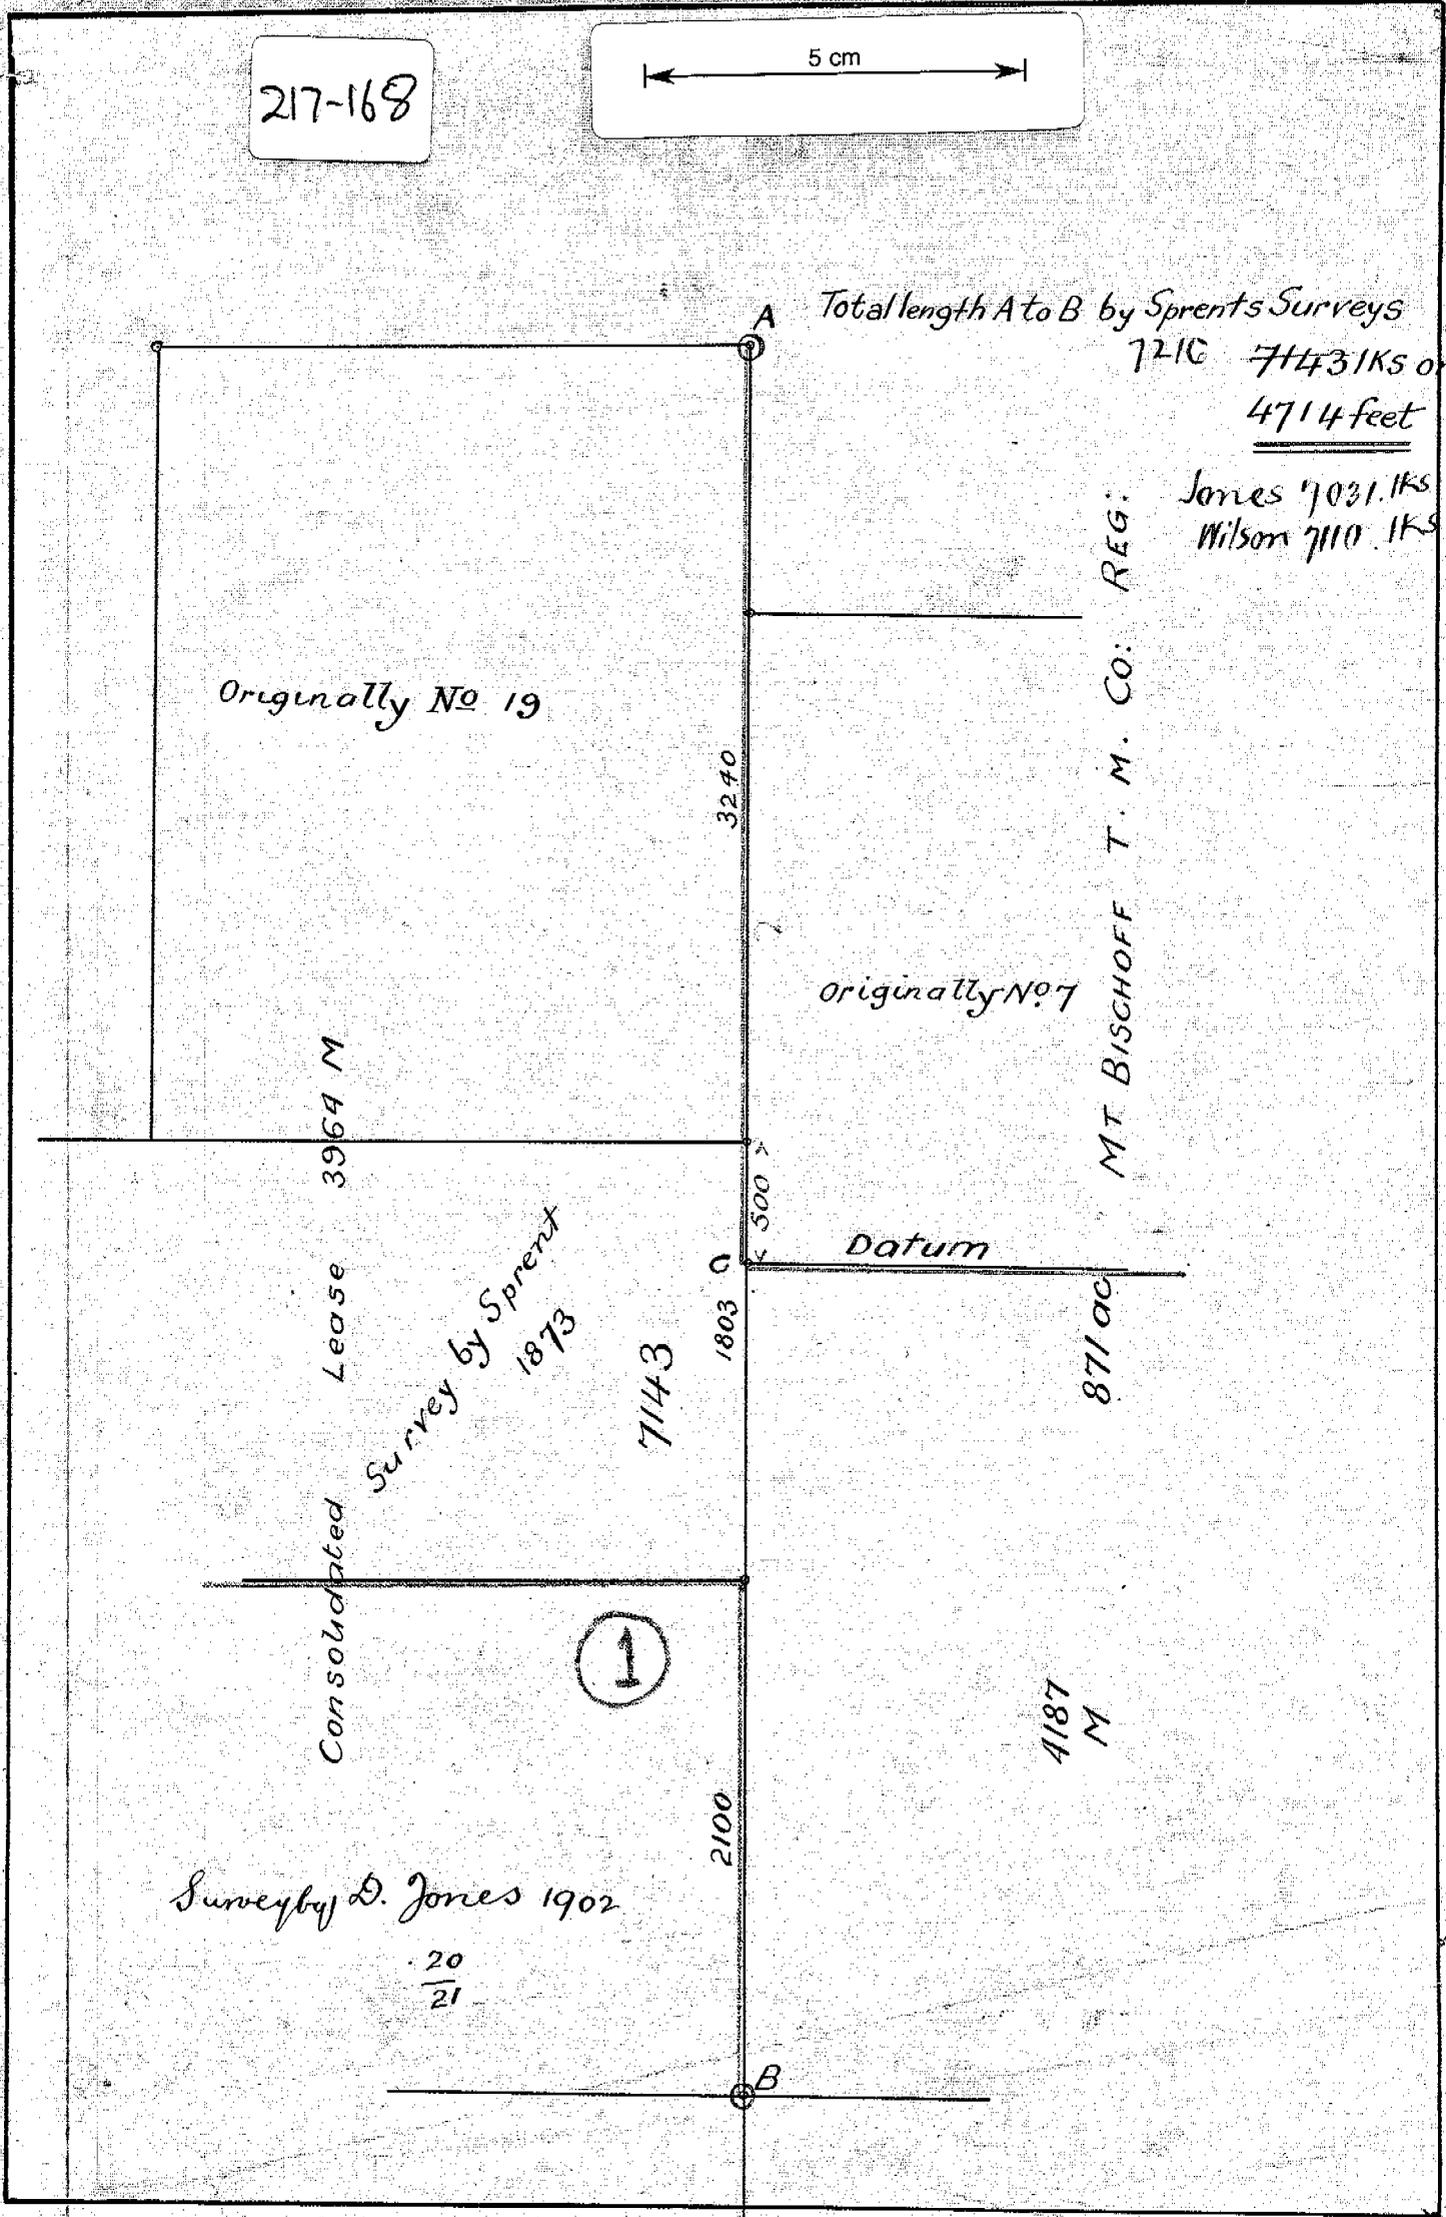


217-168

217-168

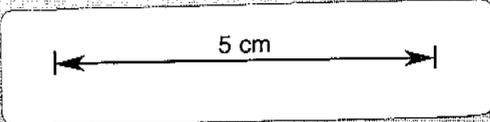

Total length A to B by Sprent's Surveys
7210 74431Ks or
4714 feet

Jones 7031.1Ks
Wilson 7110.1Ks

Originally No. 19

3240

originally No. 7

Consolidated Lease 3964 M

Survey by Sprent 1873

7143

1803

Datum

MT BISCHOFF T. M. CO. REG:

871 ac



4187 M

Survey by D. Jones 1902

20
21

2100

B

500