

217-172



217-172

7/25

To end of line

3347 approx length.
 2000
 1100
 1000
 N 1° W

Cliff covered with grass.

From 0 line


1. for Smith West line
 2500
 100
 0
 270°
 West

No 19
 Livingston Roop.

3347 Horizontal grass
 2000 Tea tree.
 1000
 0
 N 0° 30' E
 North

2400
 1000
 0
 90°
 East:

No 9.
 Commencing at the S.W. corner going along old line
 vicinity of Mr. Bischoff
 Survey of 80 acres Mineral lease

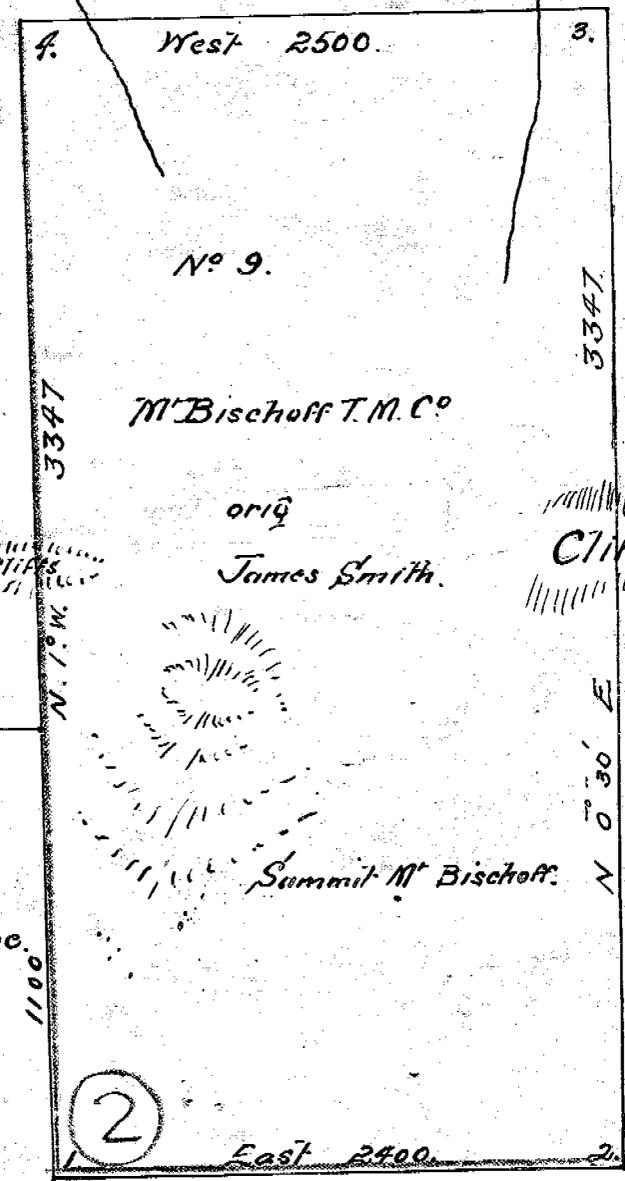

Cliffs.