

— Mr Bischoff L. M. Co Reg. —

— **GIBLIN LODE** —


— LONGITUDINAL SECTION —

— SCALE 25 FT TO 1 INCH —


217-175

5 cm

217-175

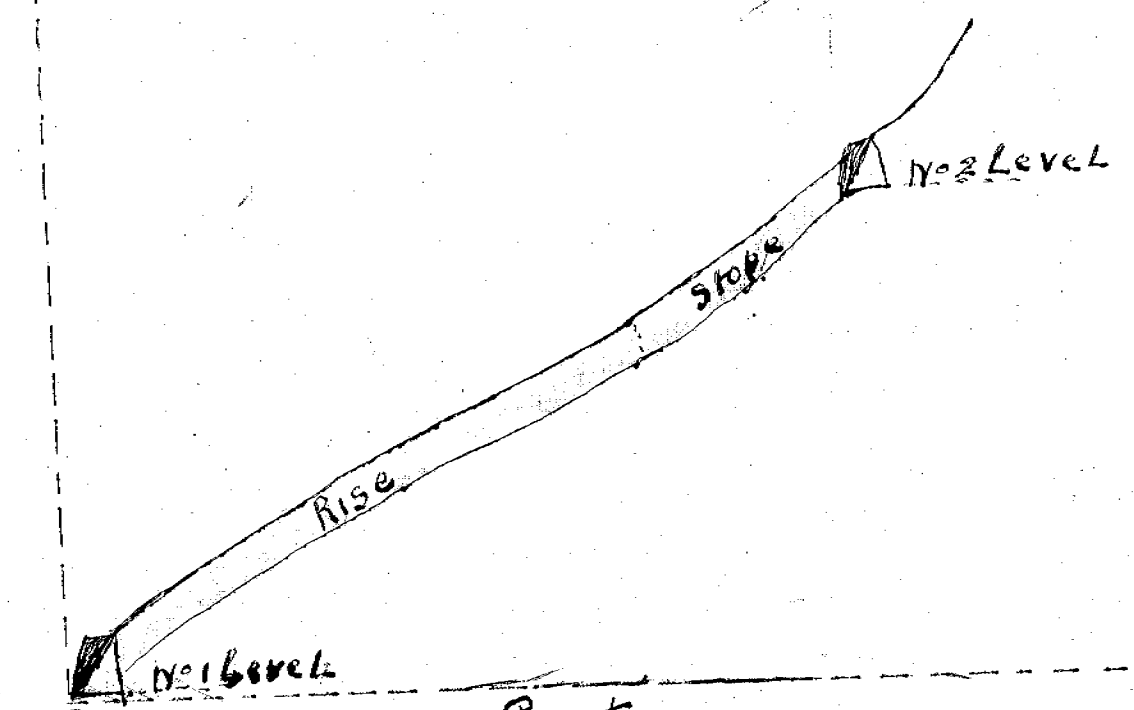

Transverse Section

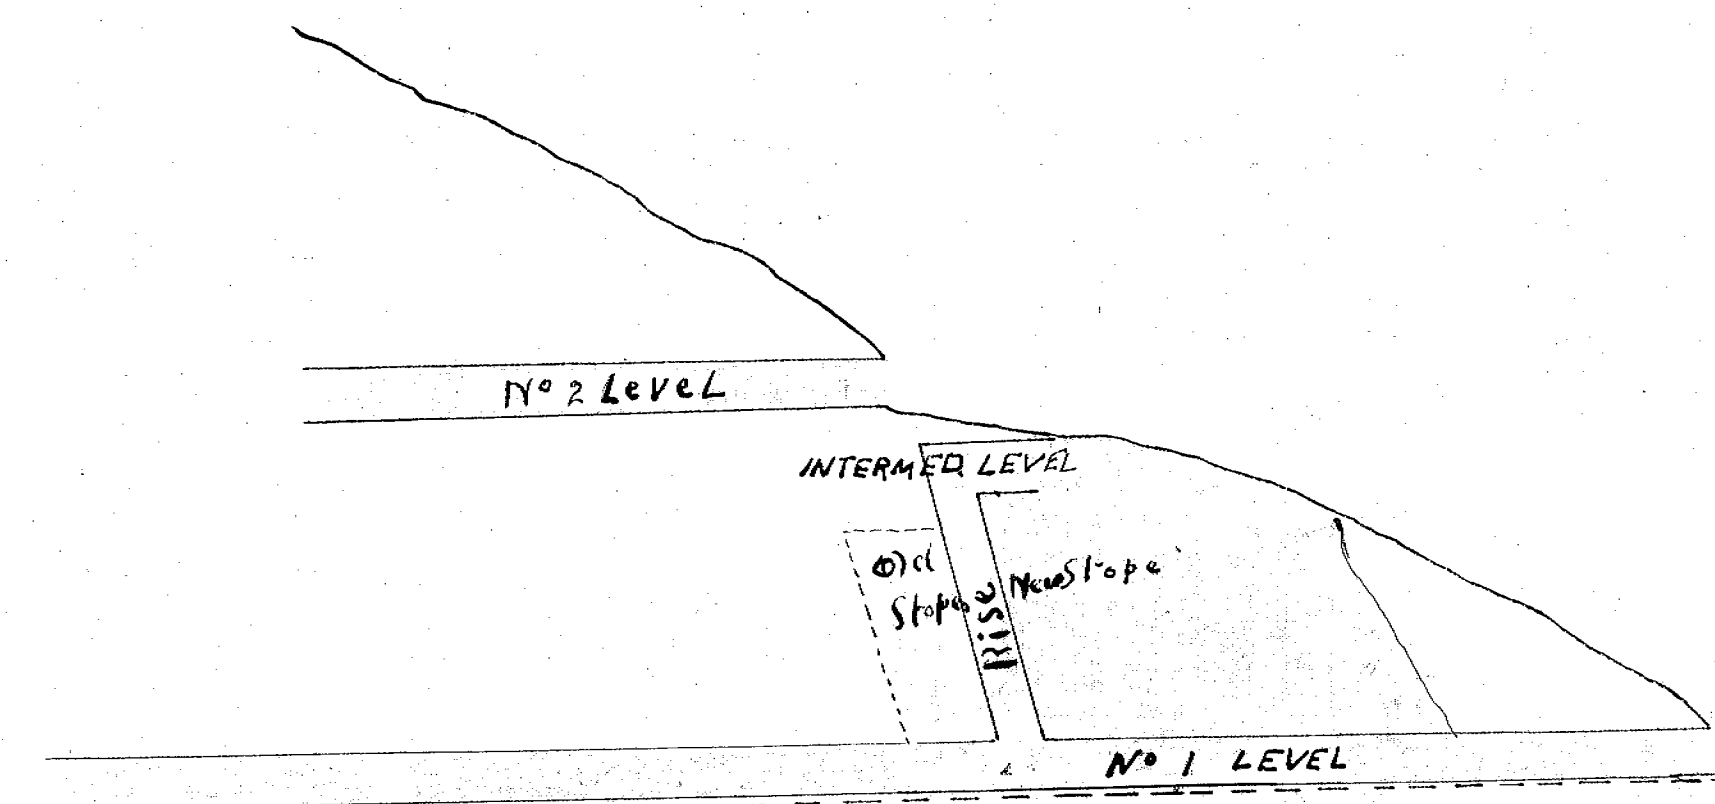

Work 1933
Surveyor W. H. Porter
Instrument used 5" theodolite