


5 cm

CIP 111


— M^r Bischoff I. M. Co Reg. —

— GIBLIN LODE —


— SCALE: 25 FT TO 1 INCH —

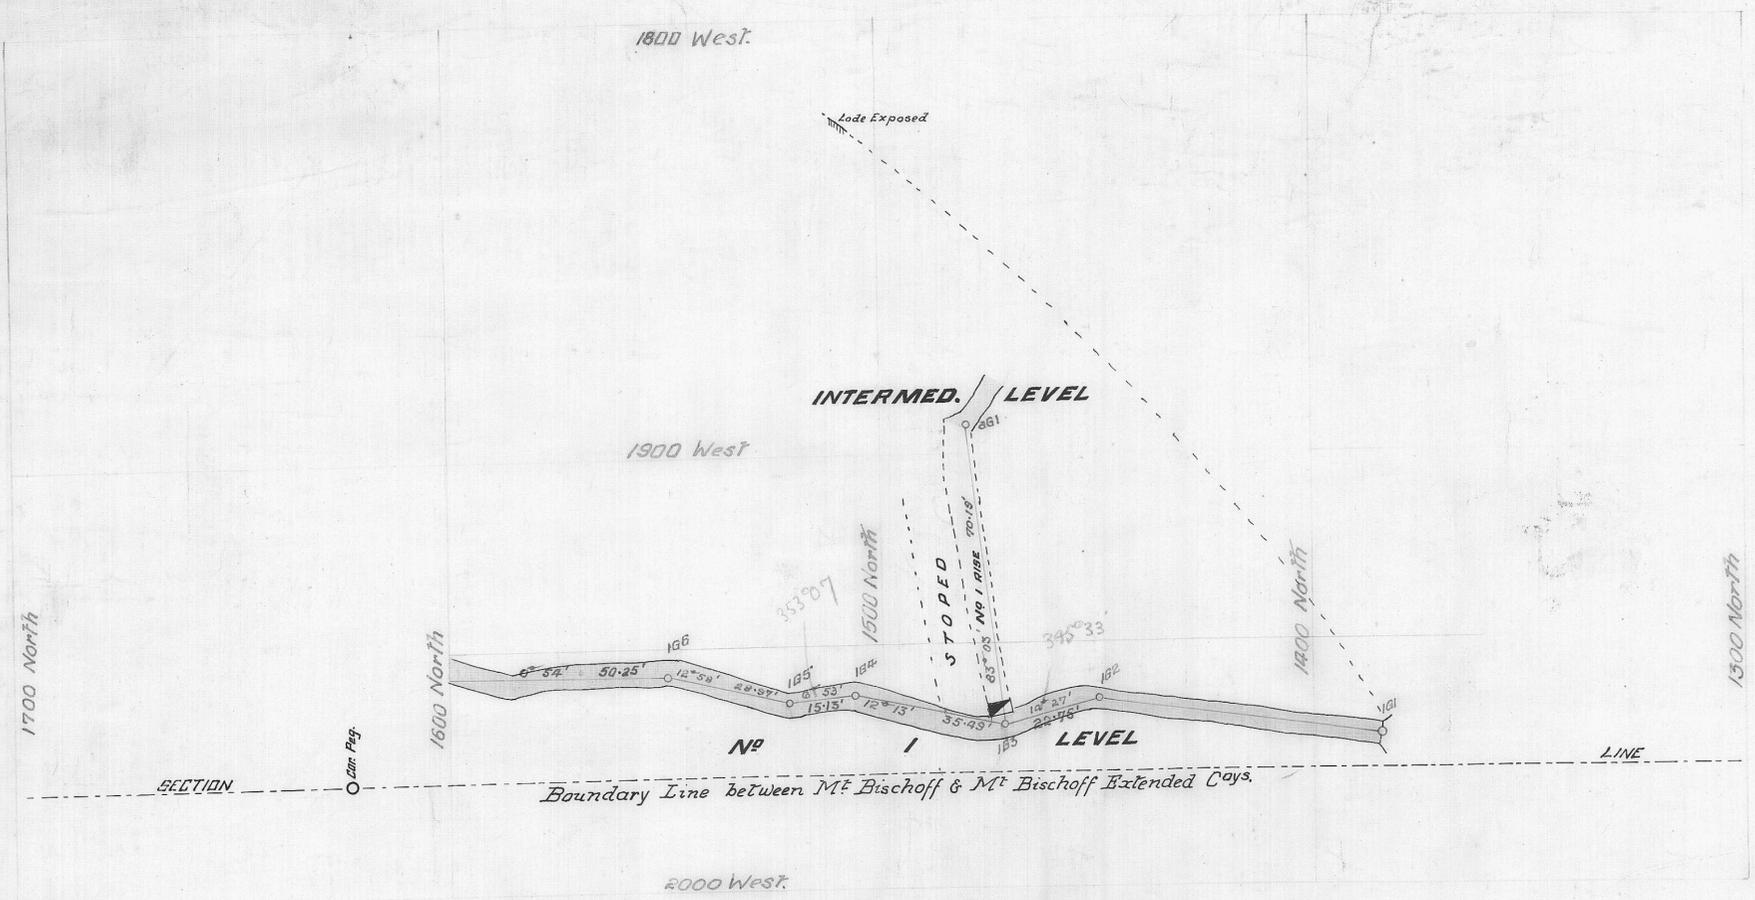

— PLAN —

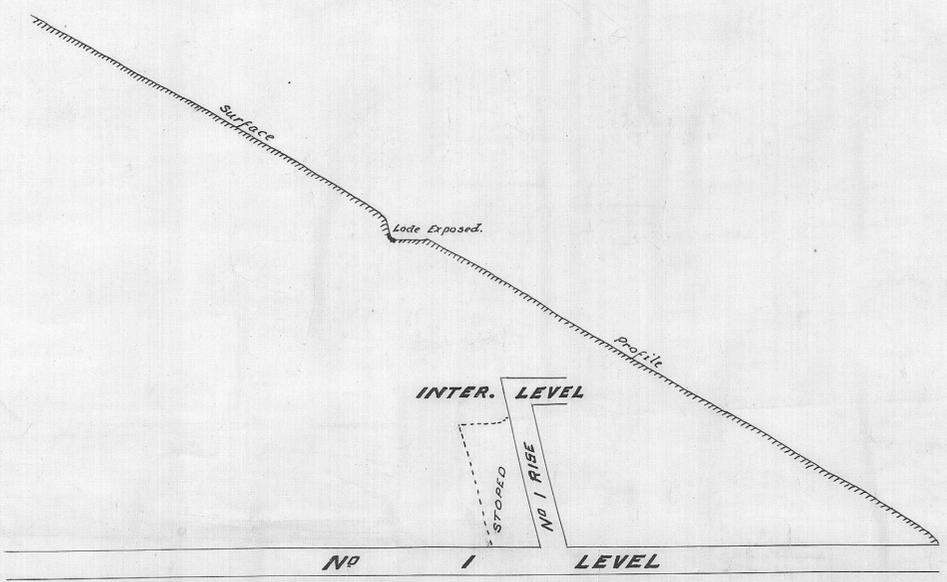

— LONGITUDINAL SECTION —

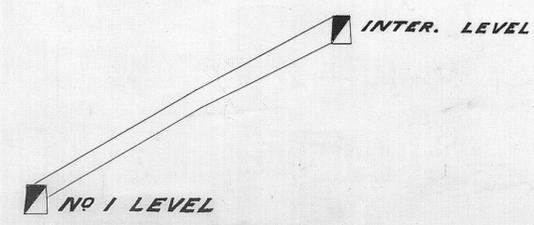

— TRANSVERSE SECTION —

Ex 1.
2-6-22

Honolulu
mine surveyor
3-22