

217-178

217-178

5 cm

1700 N

1600 N

1500 N

1400 N

2000 W
1300 N

1900 W


1800 W

1700 W

Boundary Line between Mt Bischoff & Mt Bischoff Extended Coys.

LINE A

LINE B

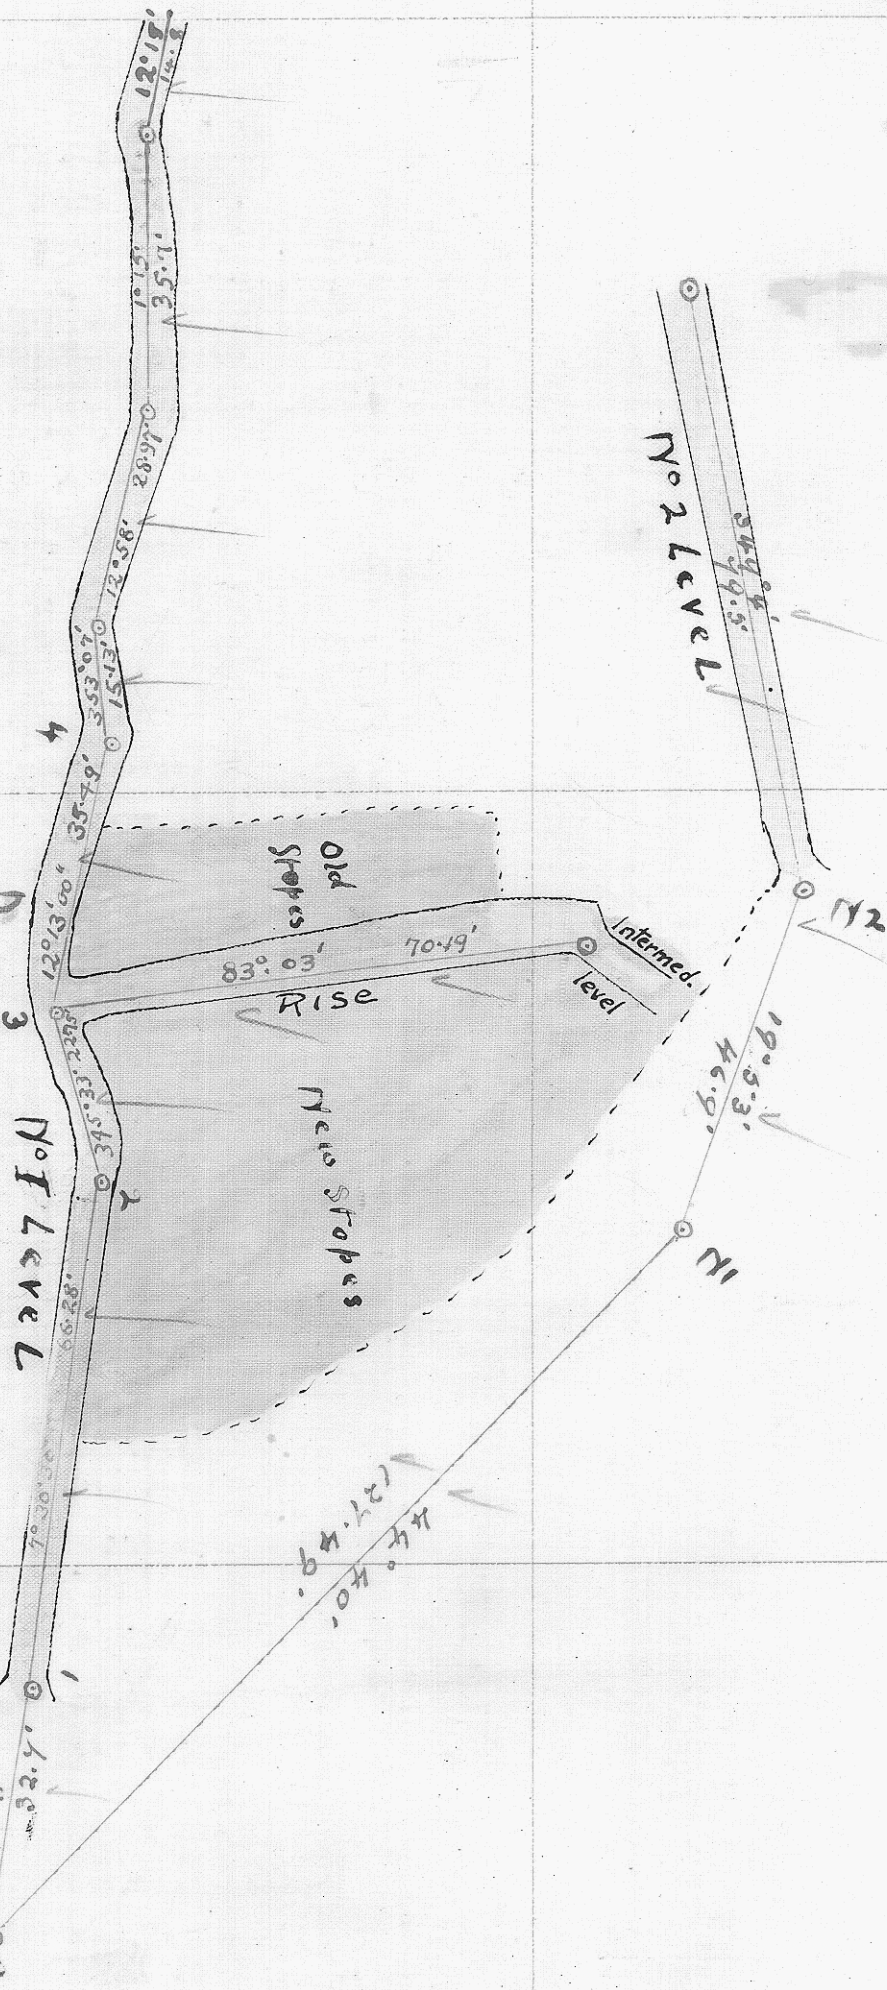

Mt Bischoff T. M. C. Reg

Giblin Code

Scale. 25 Ft to 1 Inch

Exd
29/5/34

Work 1933
Surveyor H. H. Porter
Instrument used 5" Theodolite