



217-179

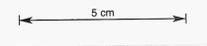

MT BISCHOFF T. M. C. REG  
WORKINGS ON CROSS LODE AND FLAT MAKE  
AND BROWN FACE SOUTH LODE  
Scale 25 ft = 1 Inch

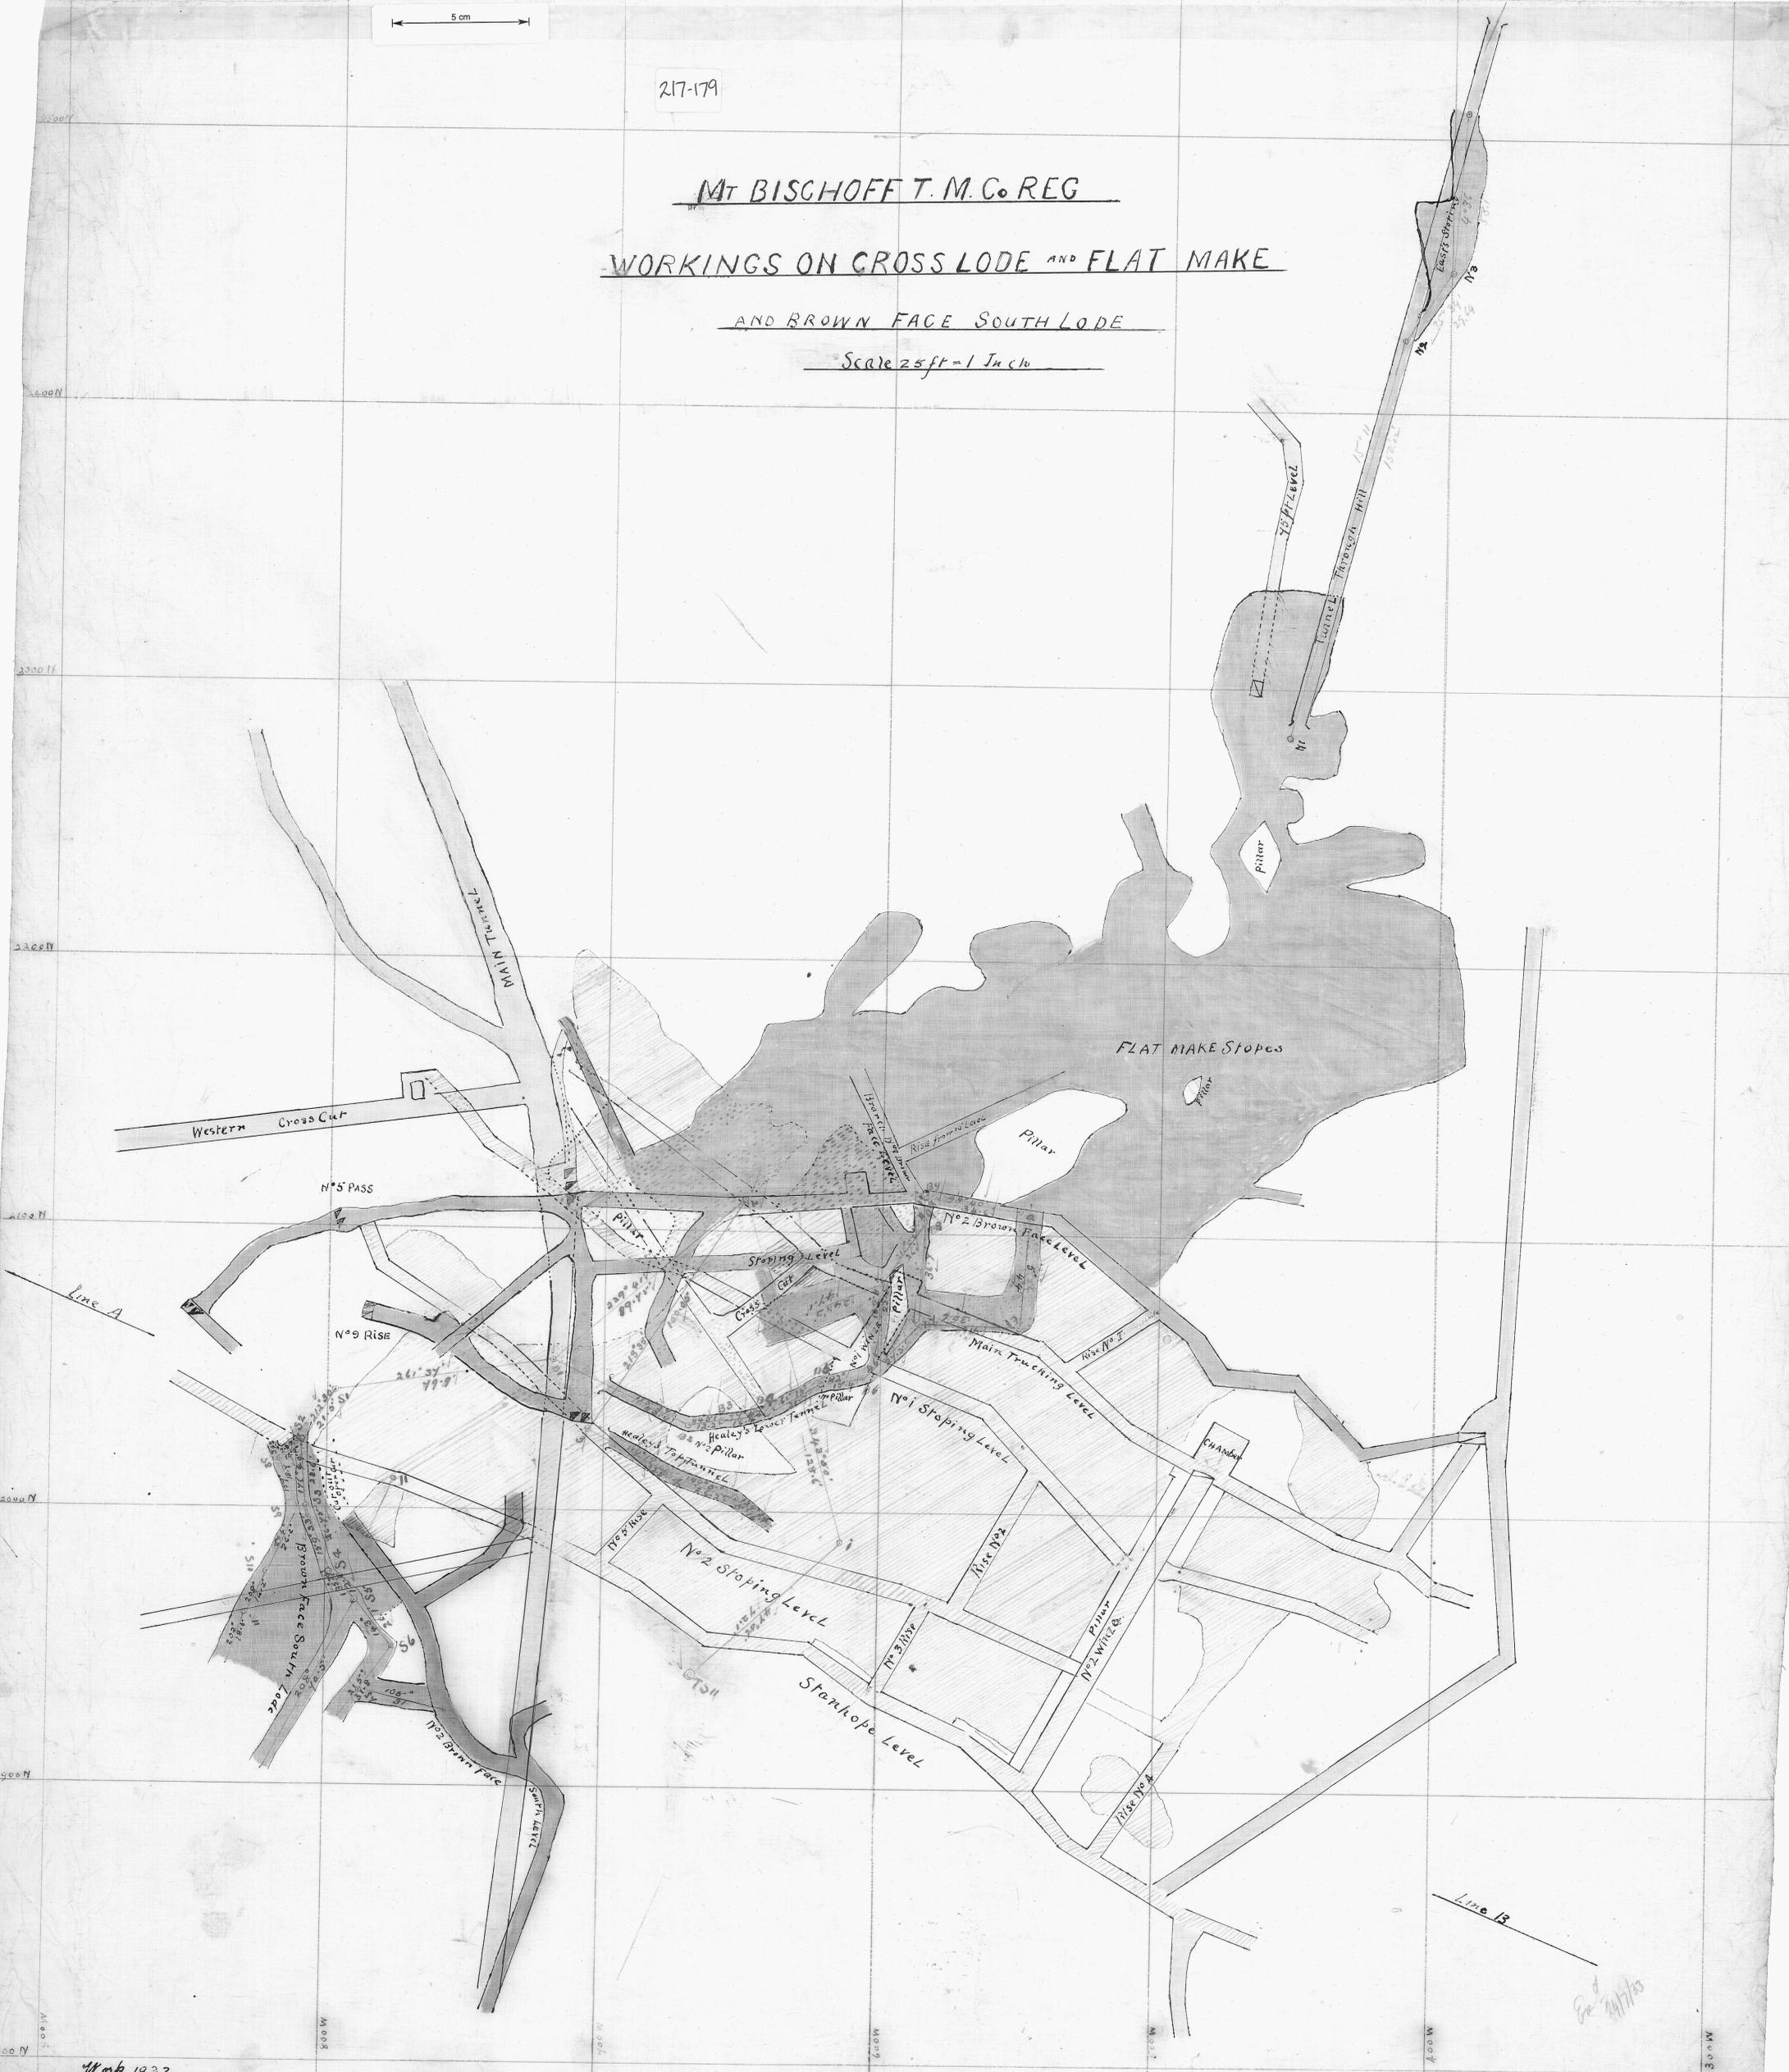

Work 1932  
 Surveyed by W. P. ...  
 Just used by Hood and Commins  
 10/9/33

Ernest ...