

H
T
R
O
N

—MT BISCHOFF T. M. CO. REG.—


—QUEEN LODGE—

—SCALE 25 FT TO 1 INCH—

217-181

5 cm

217-181

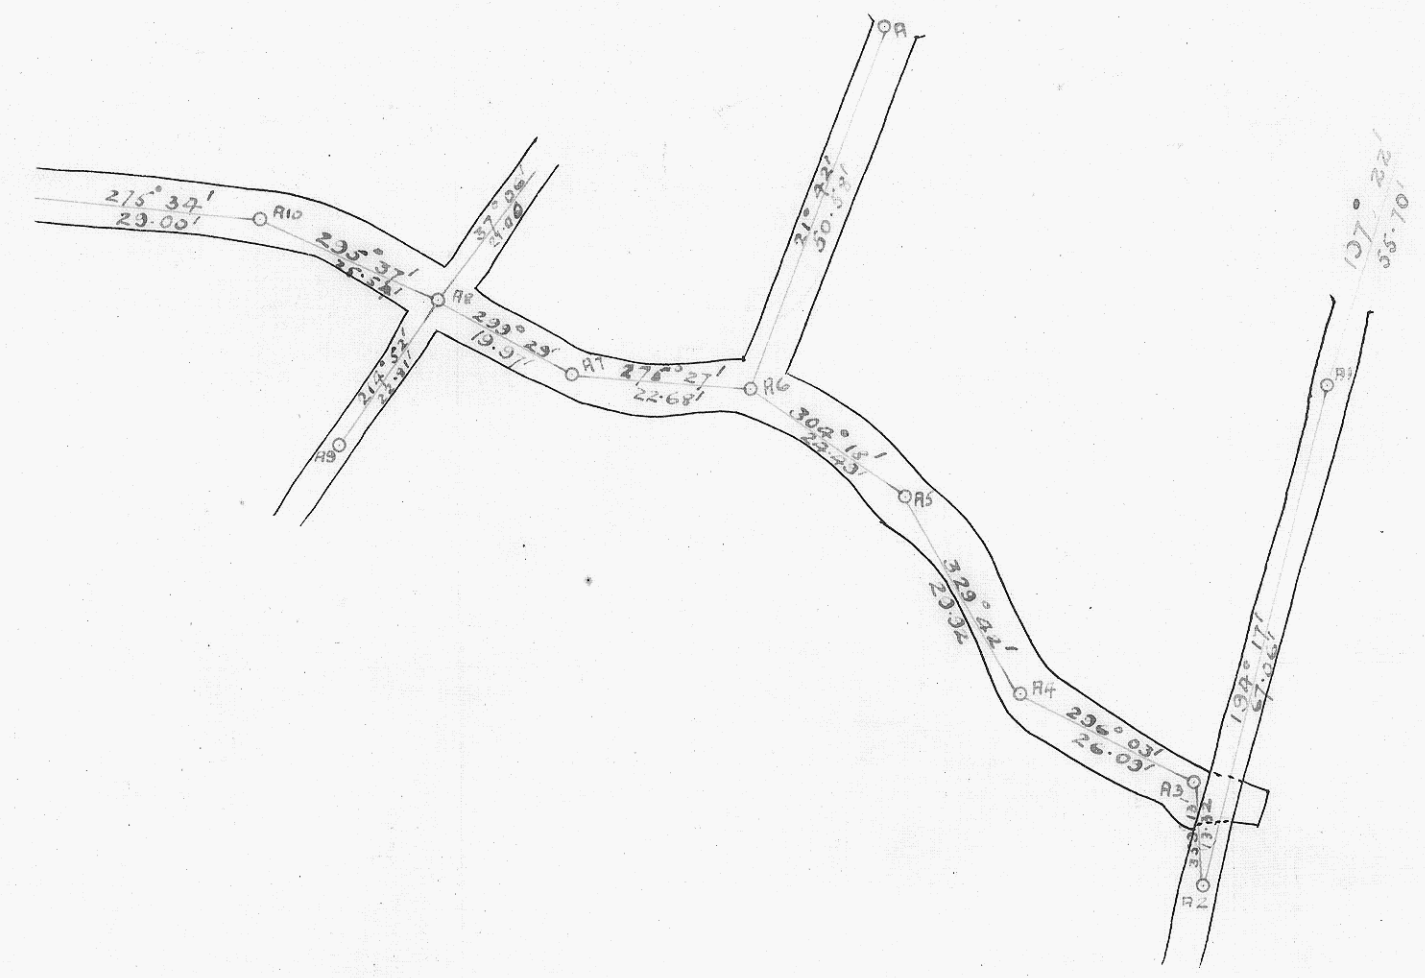

700

W

600

E

500

S

400

T

300

200

*W. Goodson
Gen. Mine Map
16-7-23*

14-7-23