


MT BISCHOFF T.M.C<sup>o</sup> REG.

CROSS SECTION QUEEN LODGE

Scale 25 feet to 1 inch.

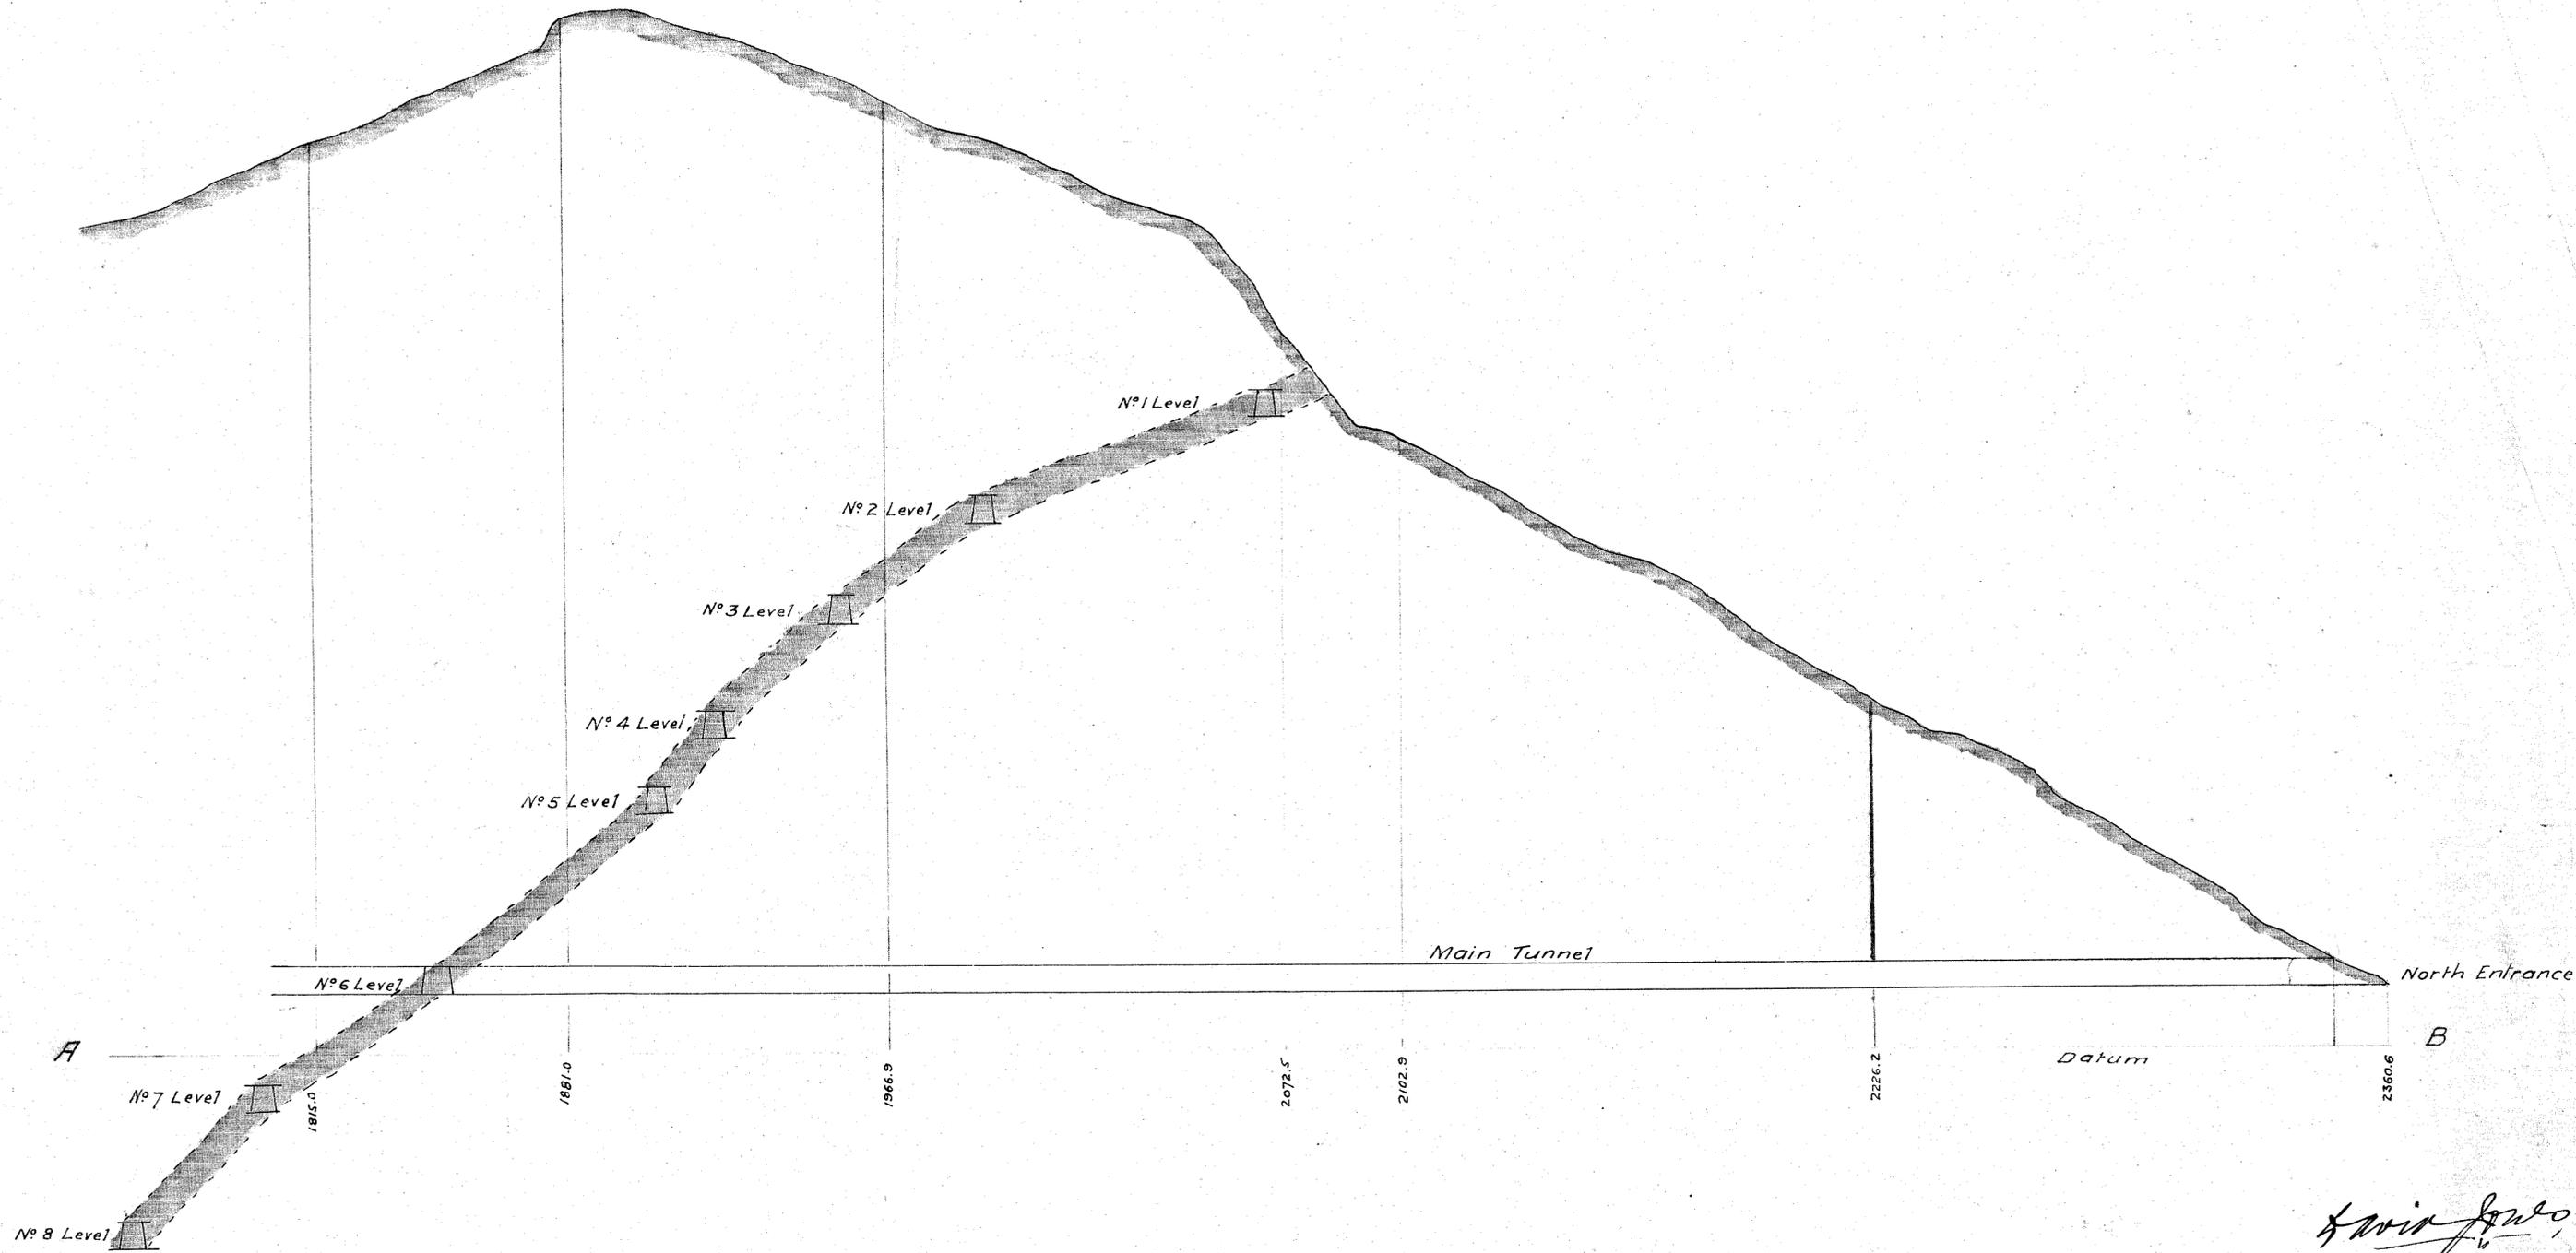

217-182

5 cm

217-182

DAVID JONES  
DISTRICT SURVEYOR  
WARREN,  
TASMANIA.

*David Jones,  
Mining Surveyor  
Warren,  
31. 7. 11.*

MT BISCHOFF - 1881