


— Mt. Bischoff T. M. Co. Reg. —
 Stopping on Queen Lode during 1924

Scale 25' = 1"

Solid Ground Hatched
 Stopped Ground Stippled

W. Bischoff
 Coy. Surveyor

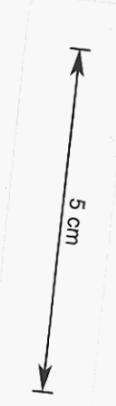

217-185

217-185