

217-187


— Mt. Bischoff T. M. Co. Reg. —

Transverse Sections, 1924 Stopes, Queen Workings.


Scale 25' = 1"

Solid Ground: Hatched; Stopped Ground: Stippled.

*W. K. ...  
Coy. Surveyor*

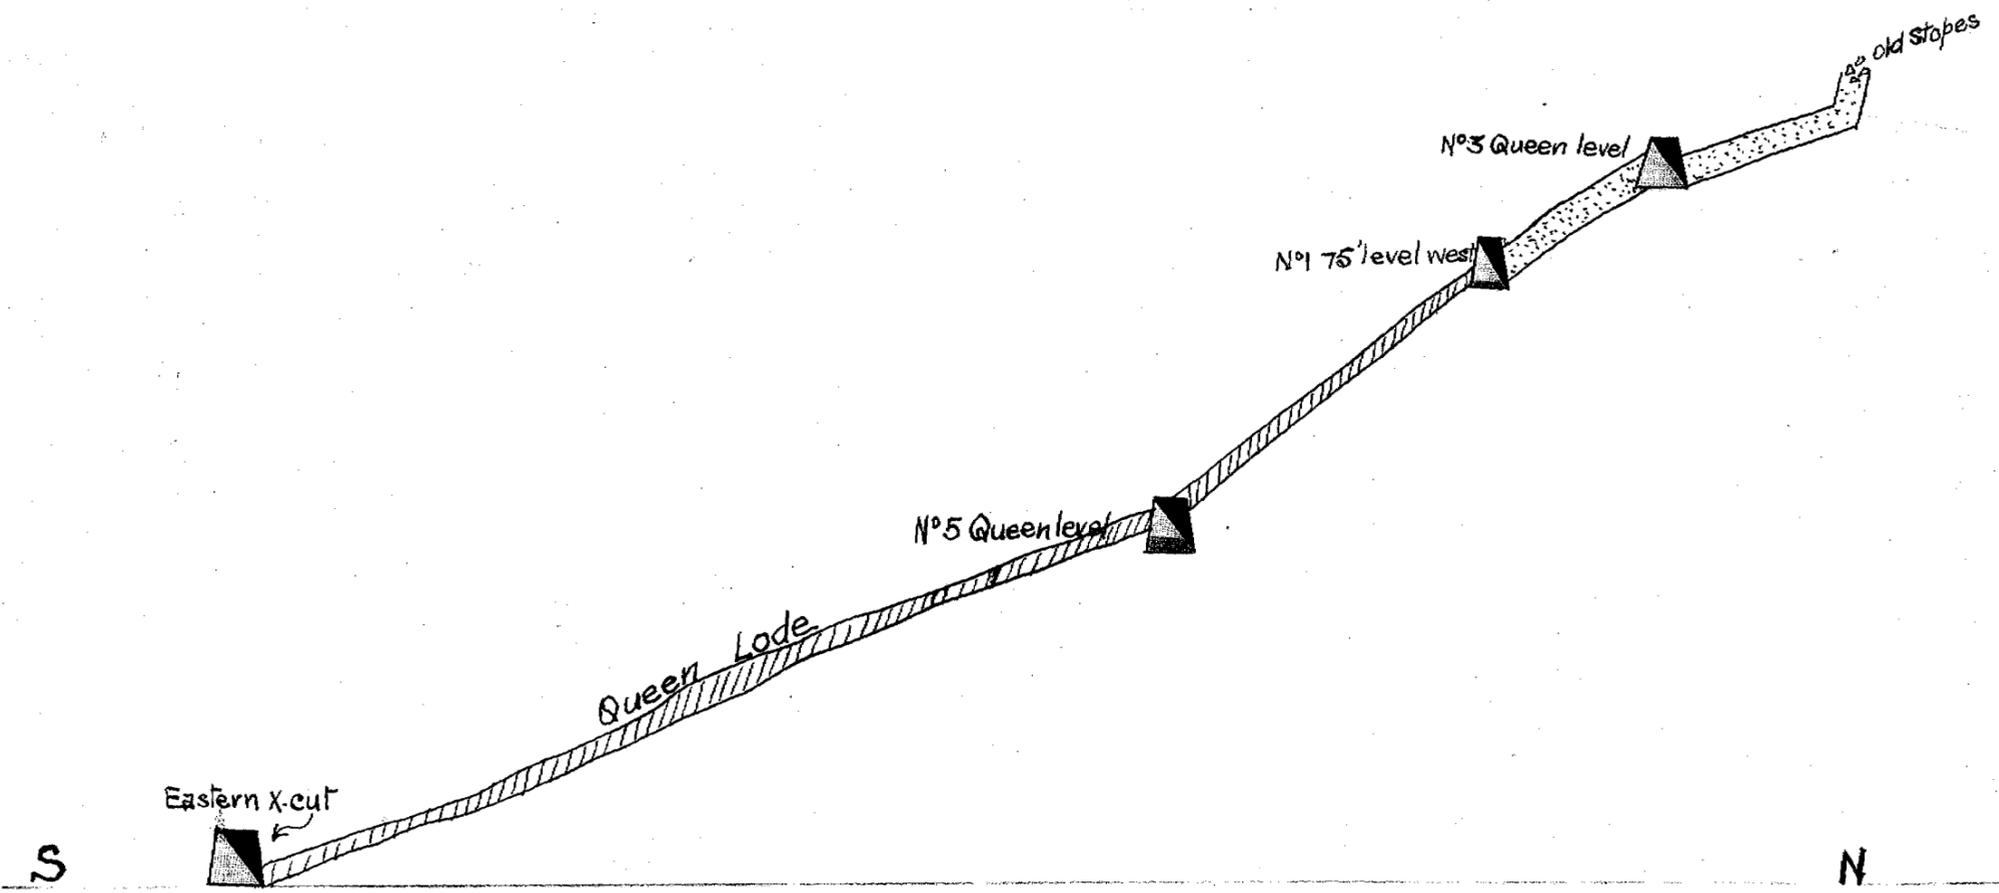

Section along AB

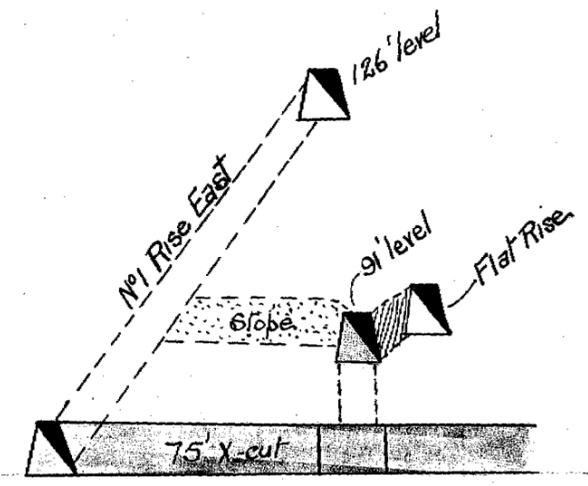

Section along EF

5 cm

217-187