



132

131

217-188

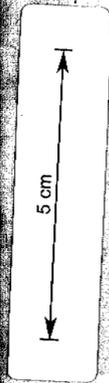

217-188

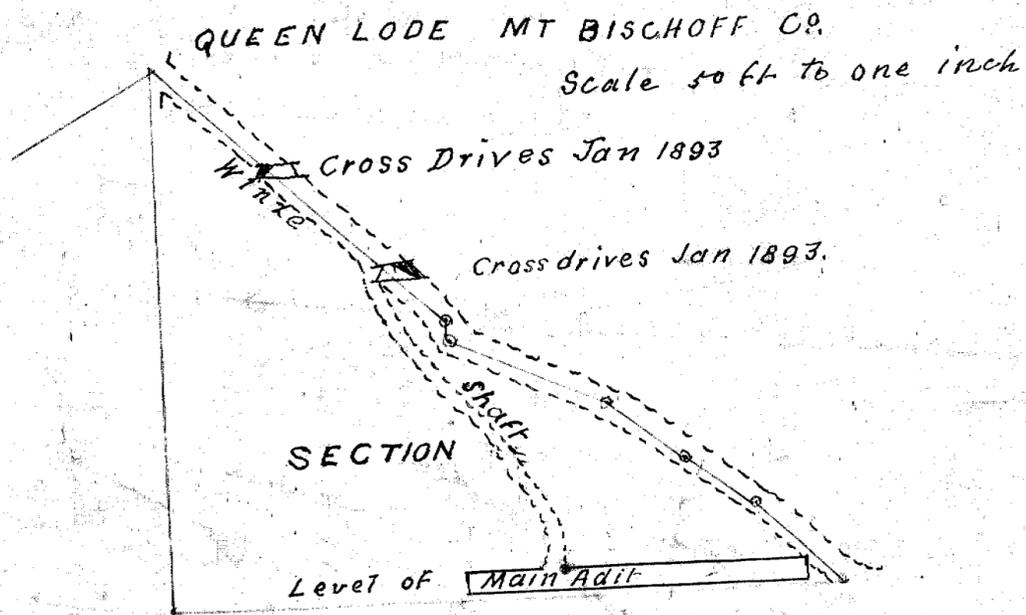

Laurie Jones
District Surveyor,
Marathon January 1893

132