


1930.

217-192

MT. BISCHOFF. T. M. C. REG.


HEALY'S TRIBUTE.

Scale - 25 ft to 1 inch.

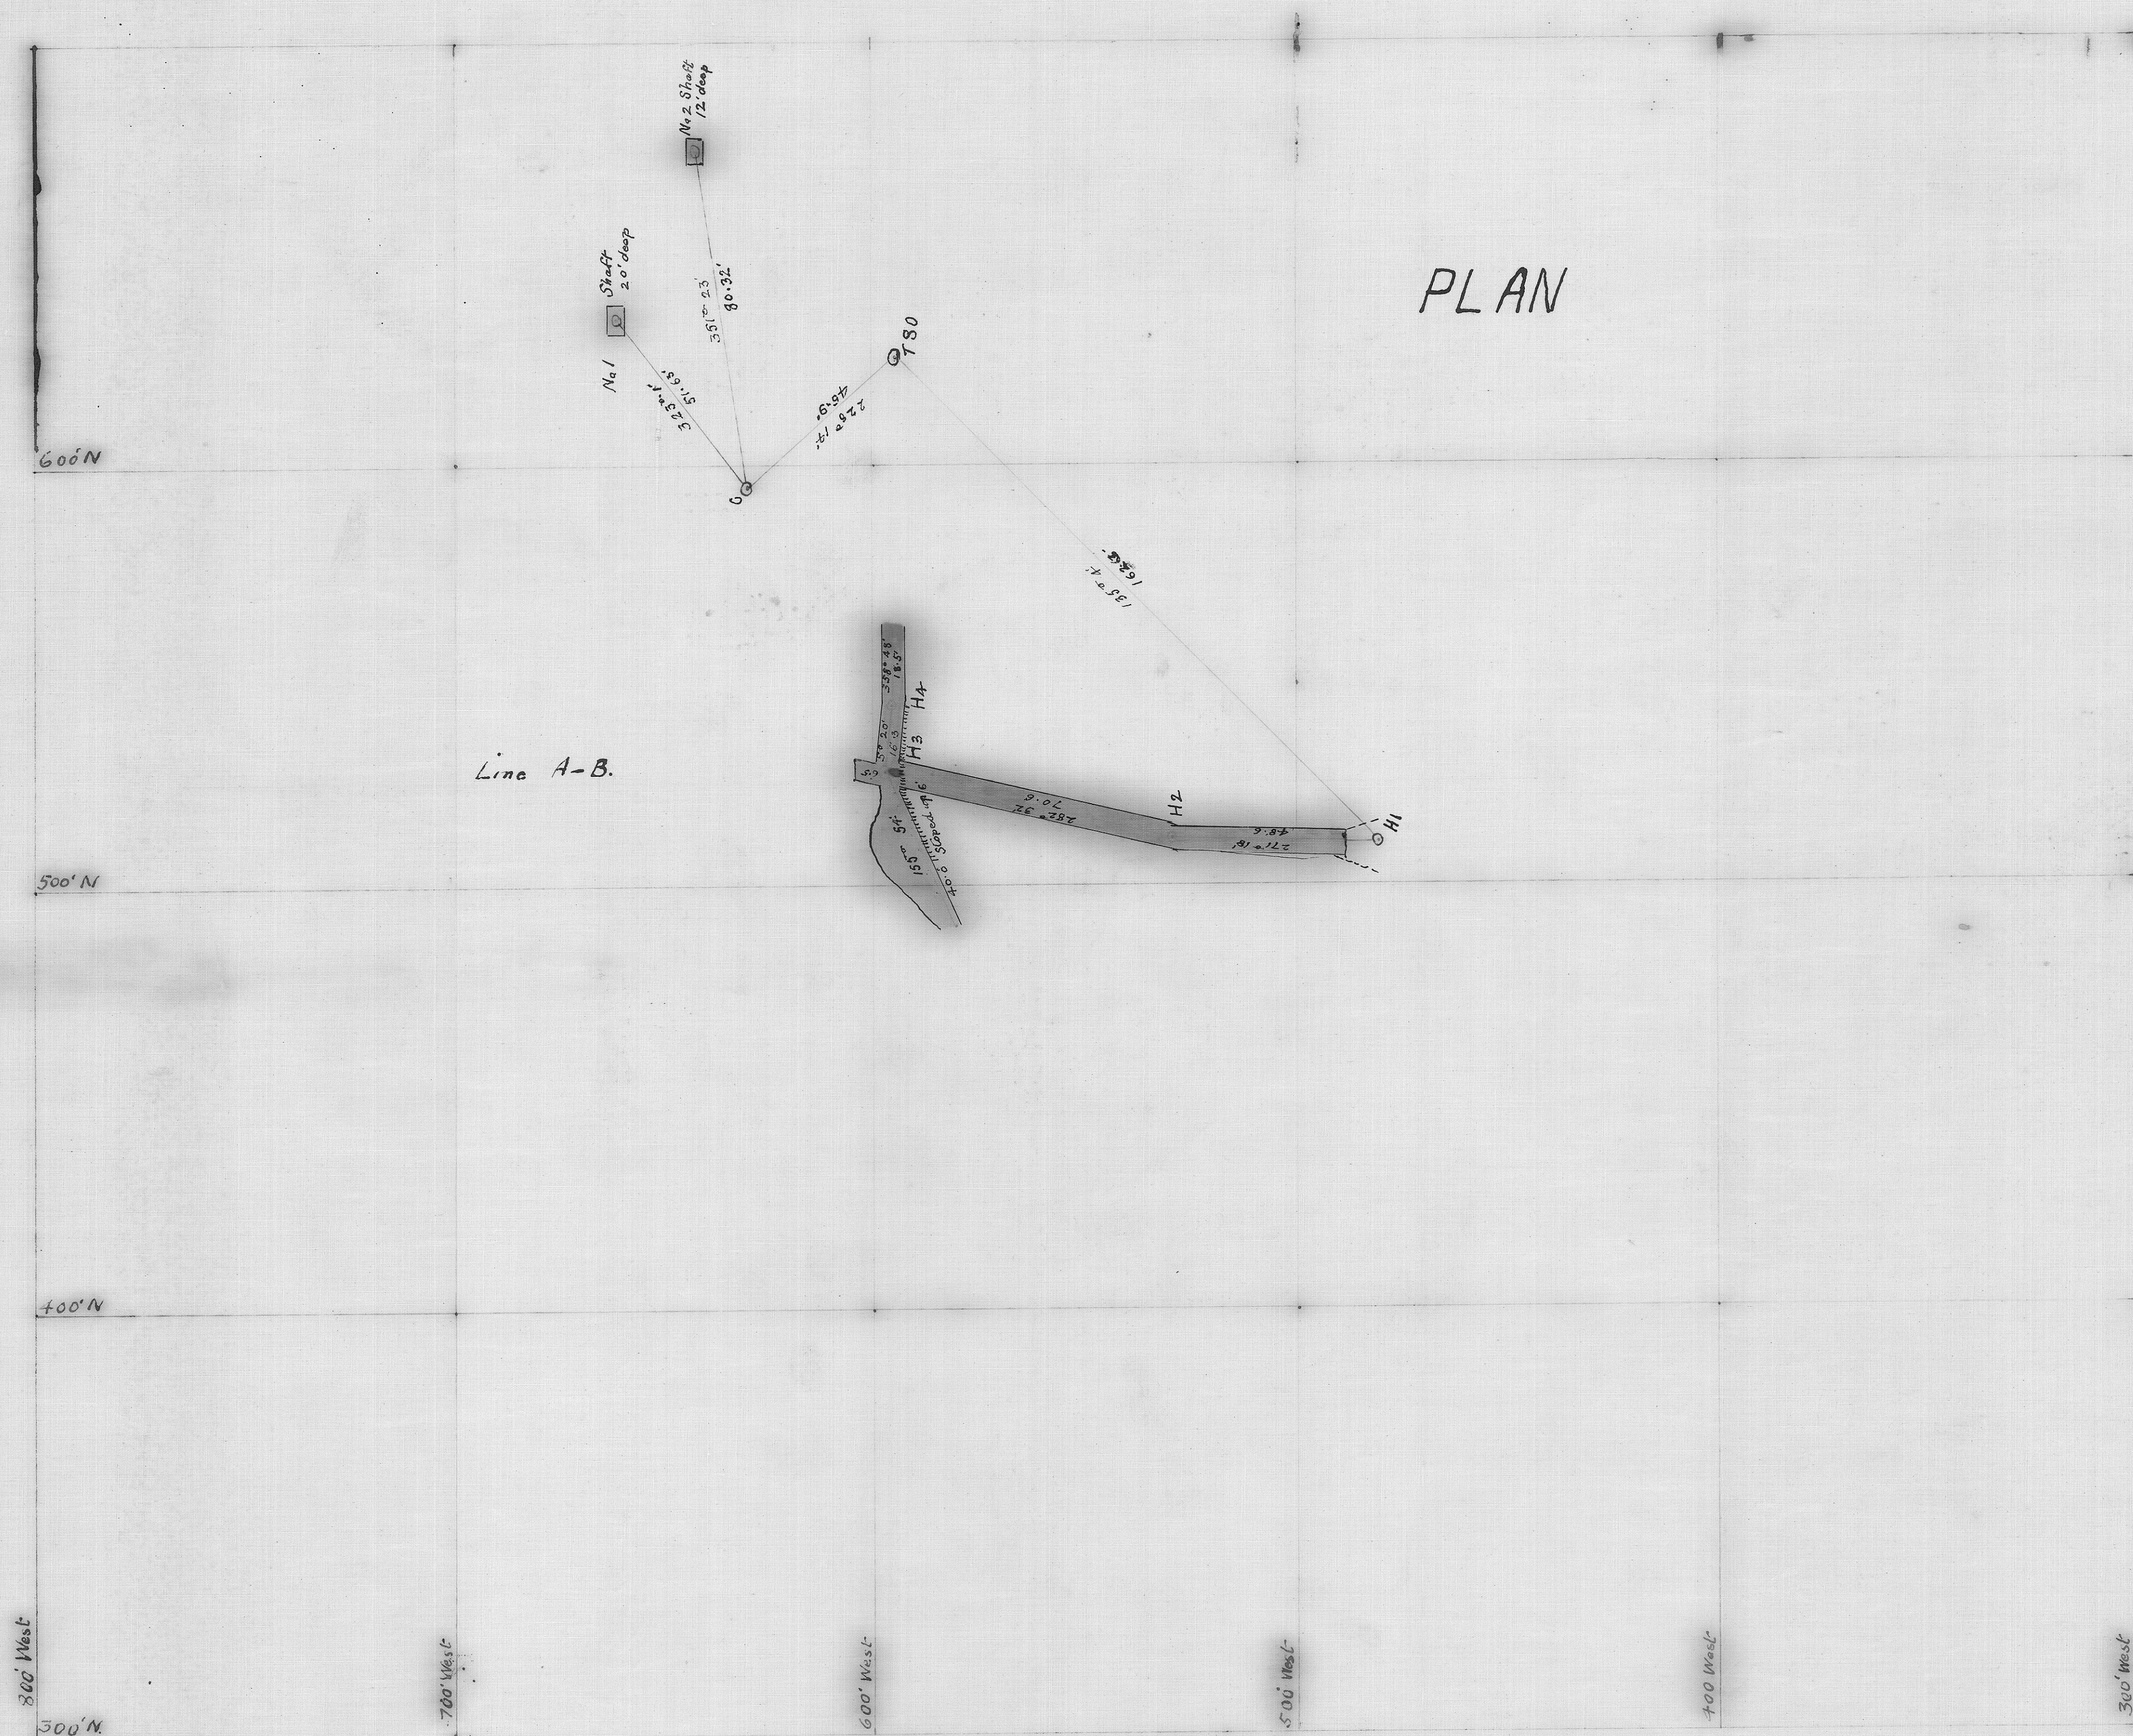

SECTION.

On Line A-B.

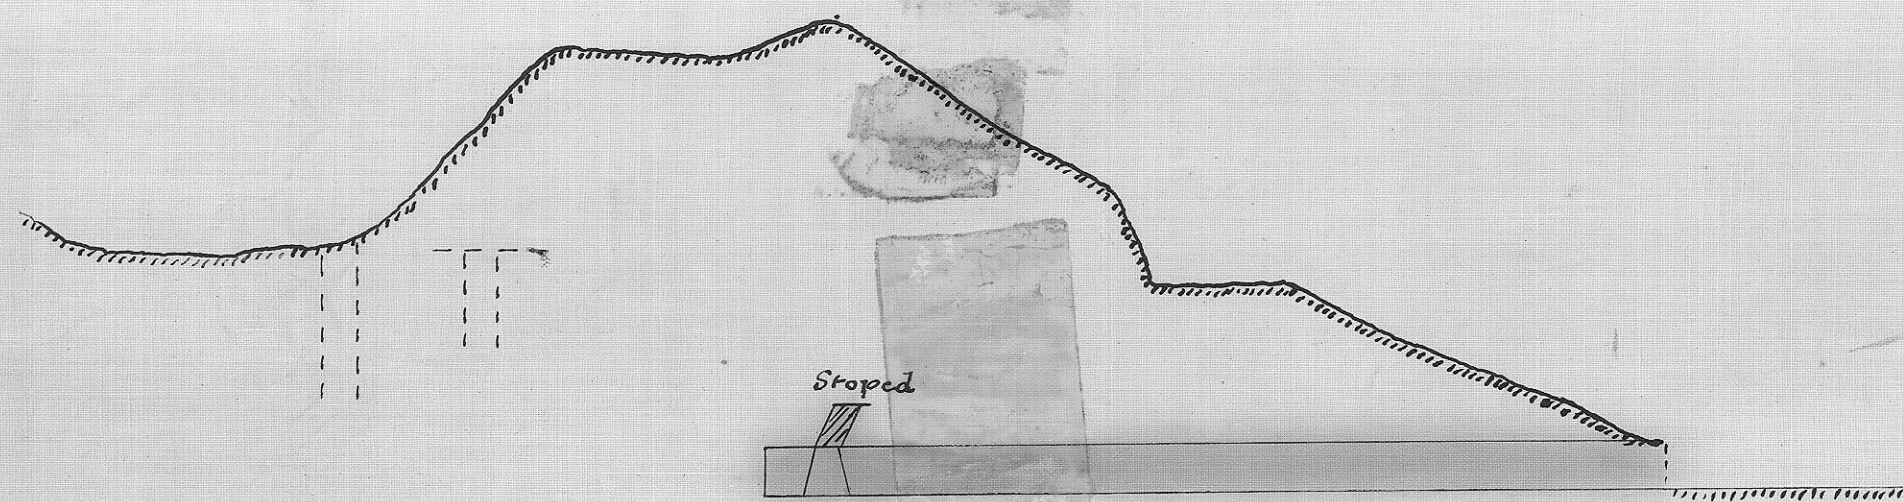

Year 1930

Inst. used 4 ft. in theodolite

Surveyors - W. H. Paul

3/13/31