


217-196


217-196

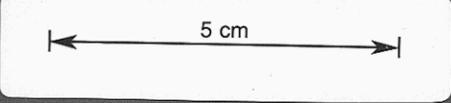

THE M^r BISCHOFF T. M. CO. REG.
 — PLAN OF WORKINGS —
 — AT —
 — 25th JUNE 1920. —
 — Scale: 250^{ft} to 1 Inch —

SURFACE EXTENSIONS
 UNDERGROUND EXTENSIONS
 (For Full View)

Each Section
 represents
 200 Feet
 Square.

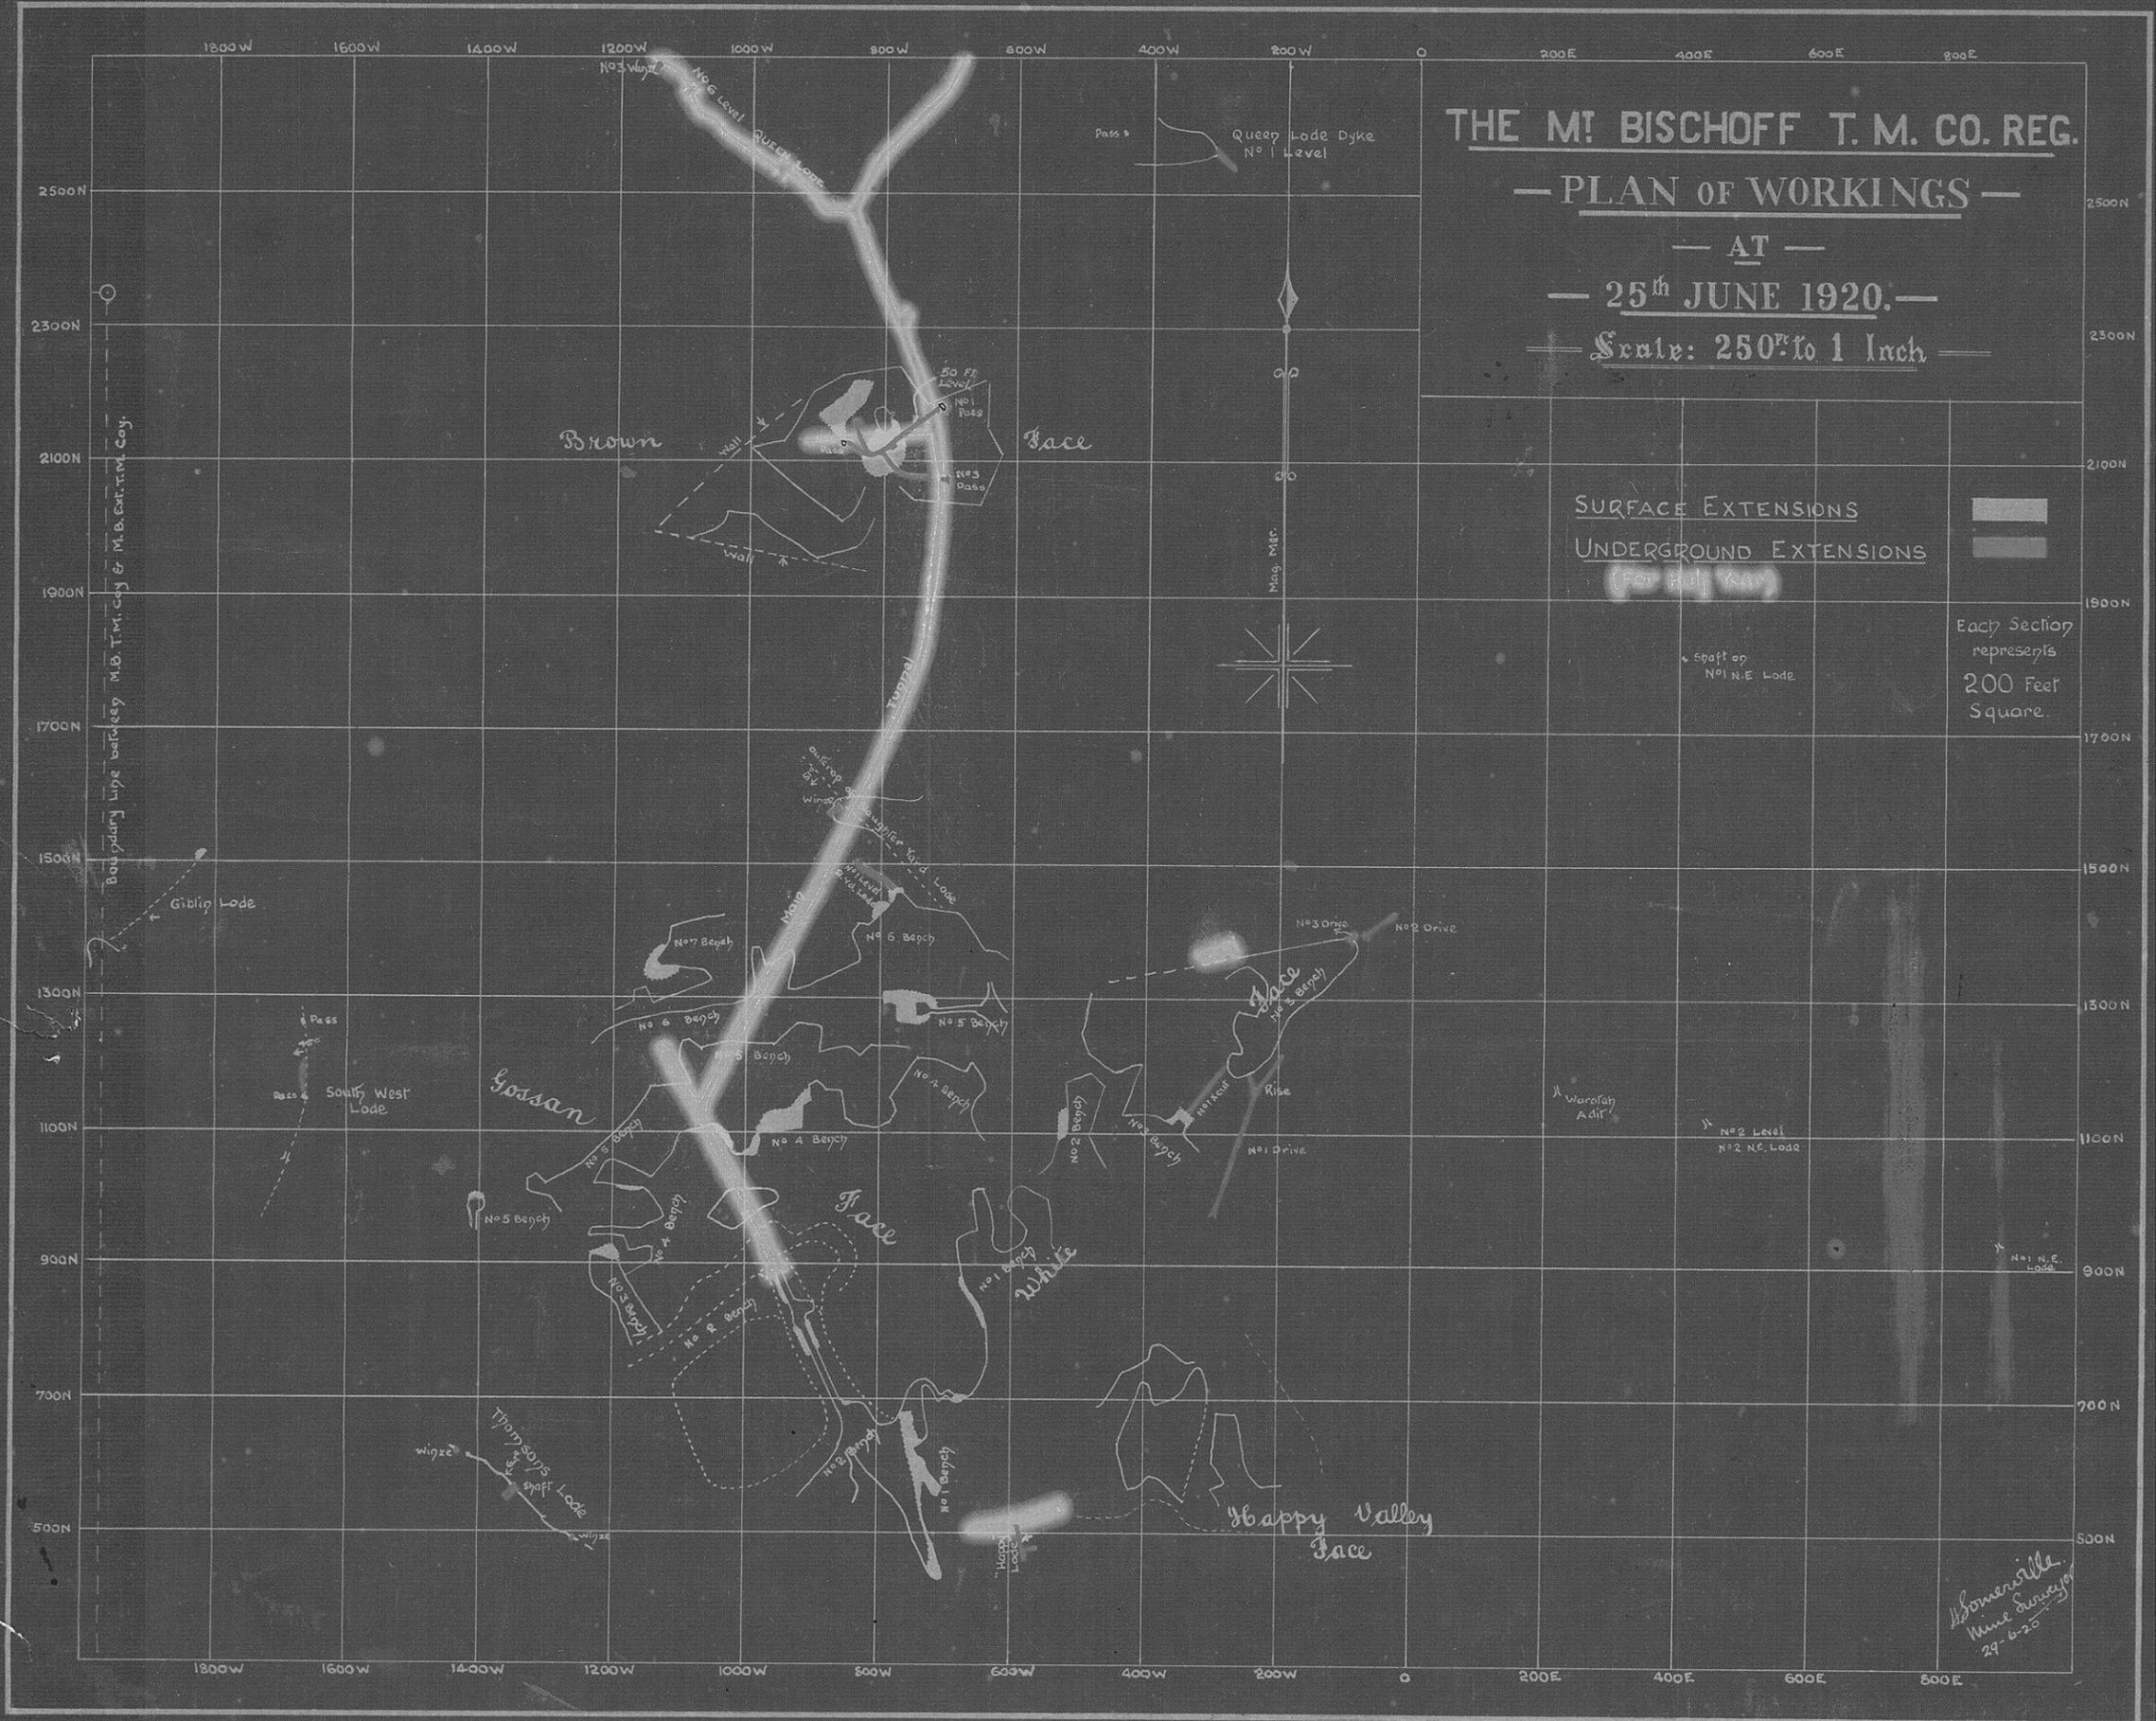

Bowersville
 Mine Surveyor
 29-6-20