




217-200


- MT BISCHOFF T. M. CO. REG. - - BROWN FACE -

UNDERGROUND WORKINGS FOR YEAR ENDING 31.12.25.

J. H. Lewis General Manager. Scale 25 Feet to 1 Inch. Date 11/2/26.

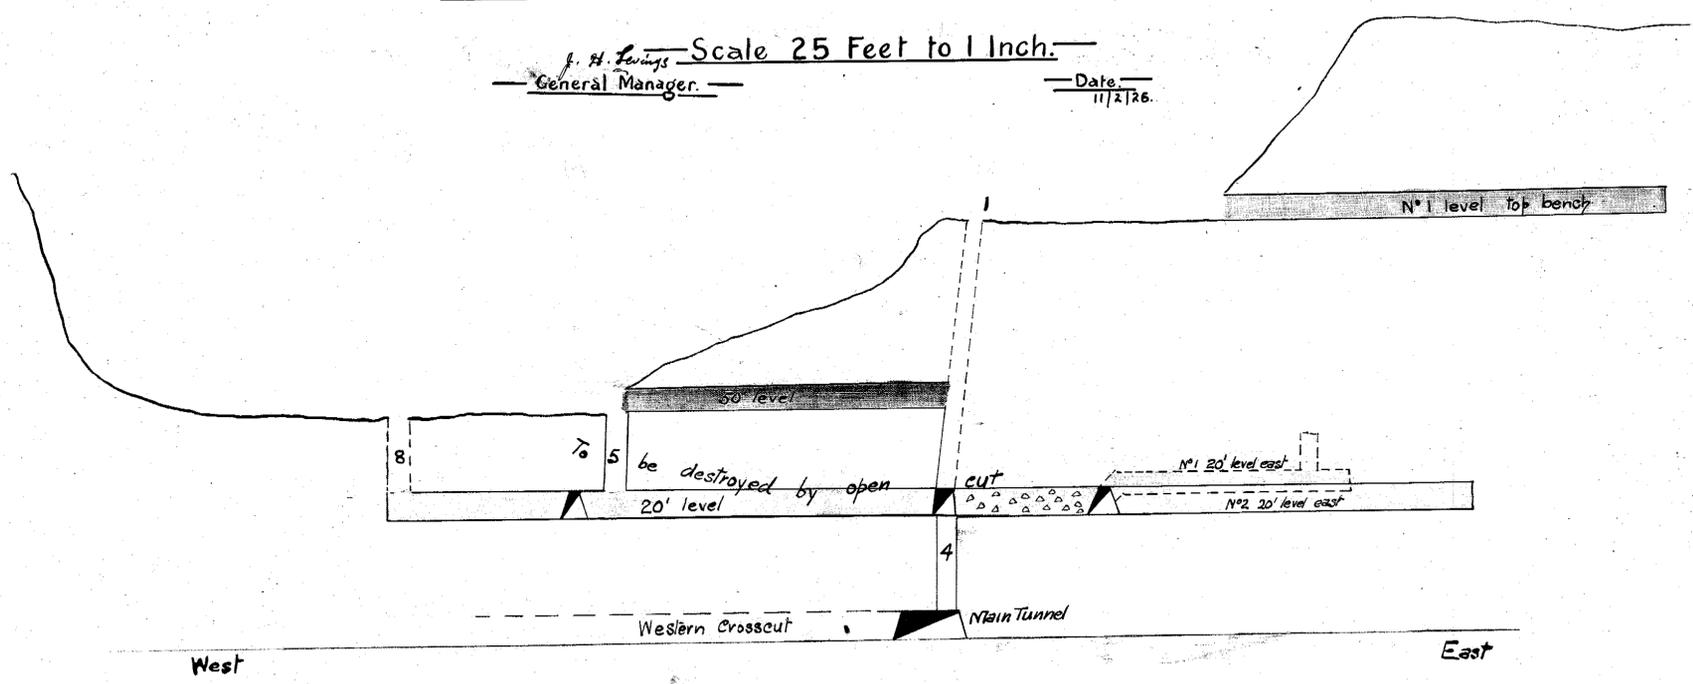

Longitudinal Section
Scale 25' = 1"

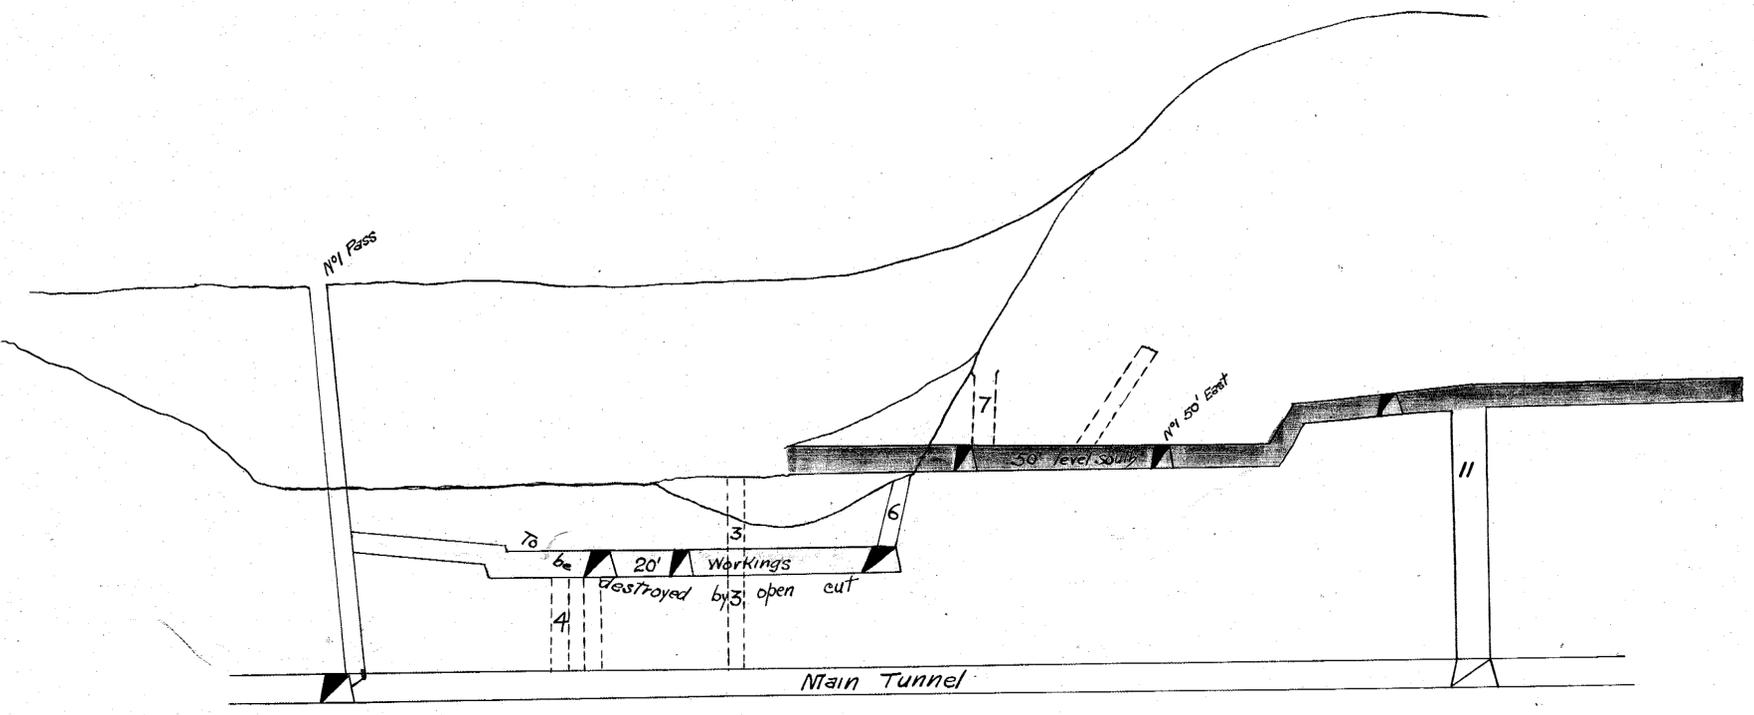

Transverse Section
Scale 25' = 1"

Note: This transverse section corrects that sent to Mines Dept for year ending 31.12.25, which had to be made from incomplete field notes of previous surveyor, the 50' level south having suddenly been rendered inaccessible by fire at entrance. The correction centres around N°11 Pass.
 J. H. Lewis
 Gen. Manager