



217202

MT. BISCHOFF T.M.CO. REG.

DRIVES TO S.W. CORNER OF BROWN FACE

1929.

SCALE 25 FT. = 1 IN.

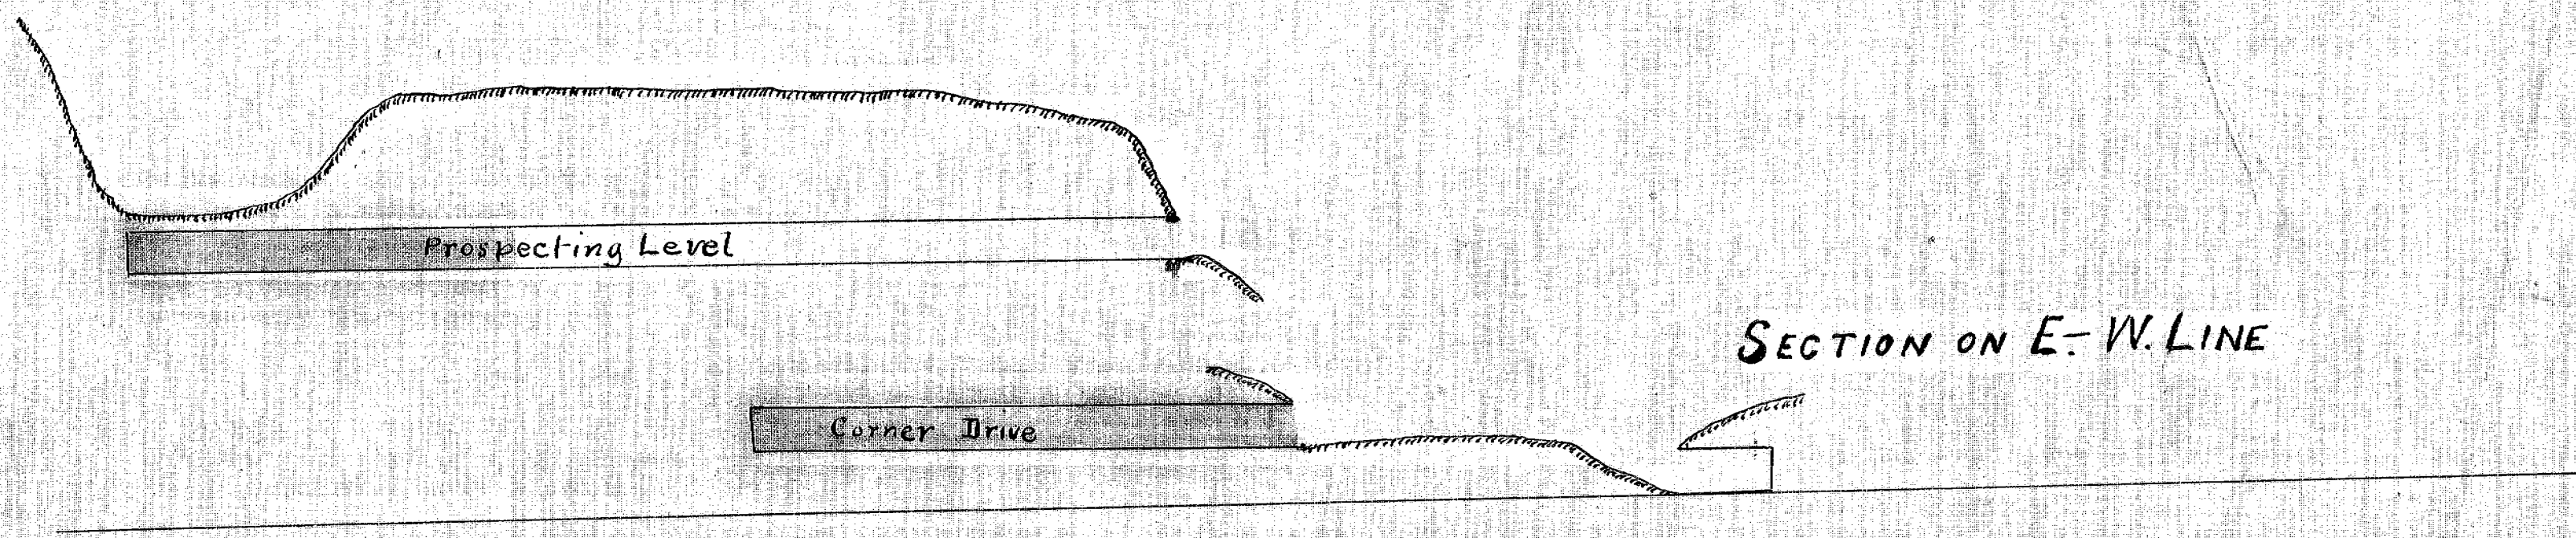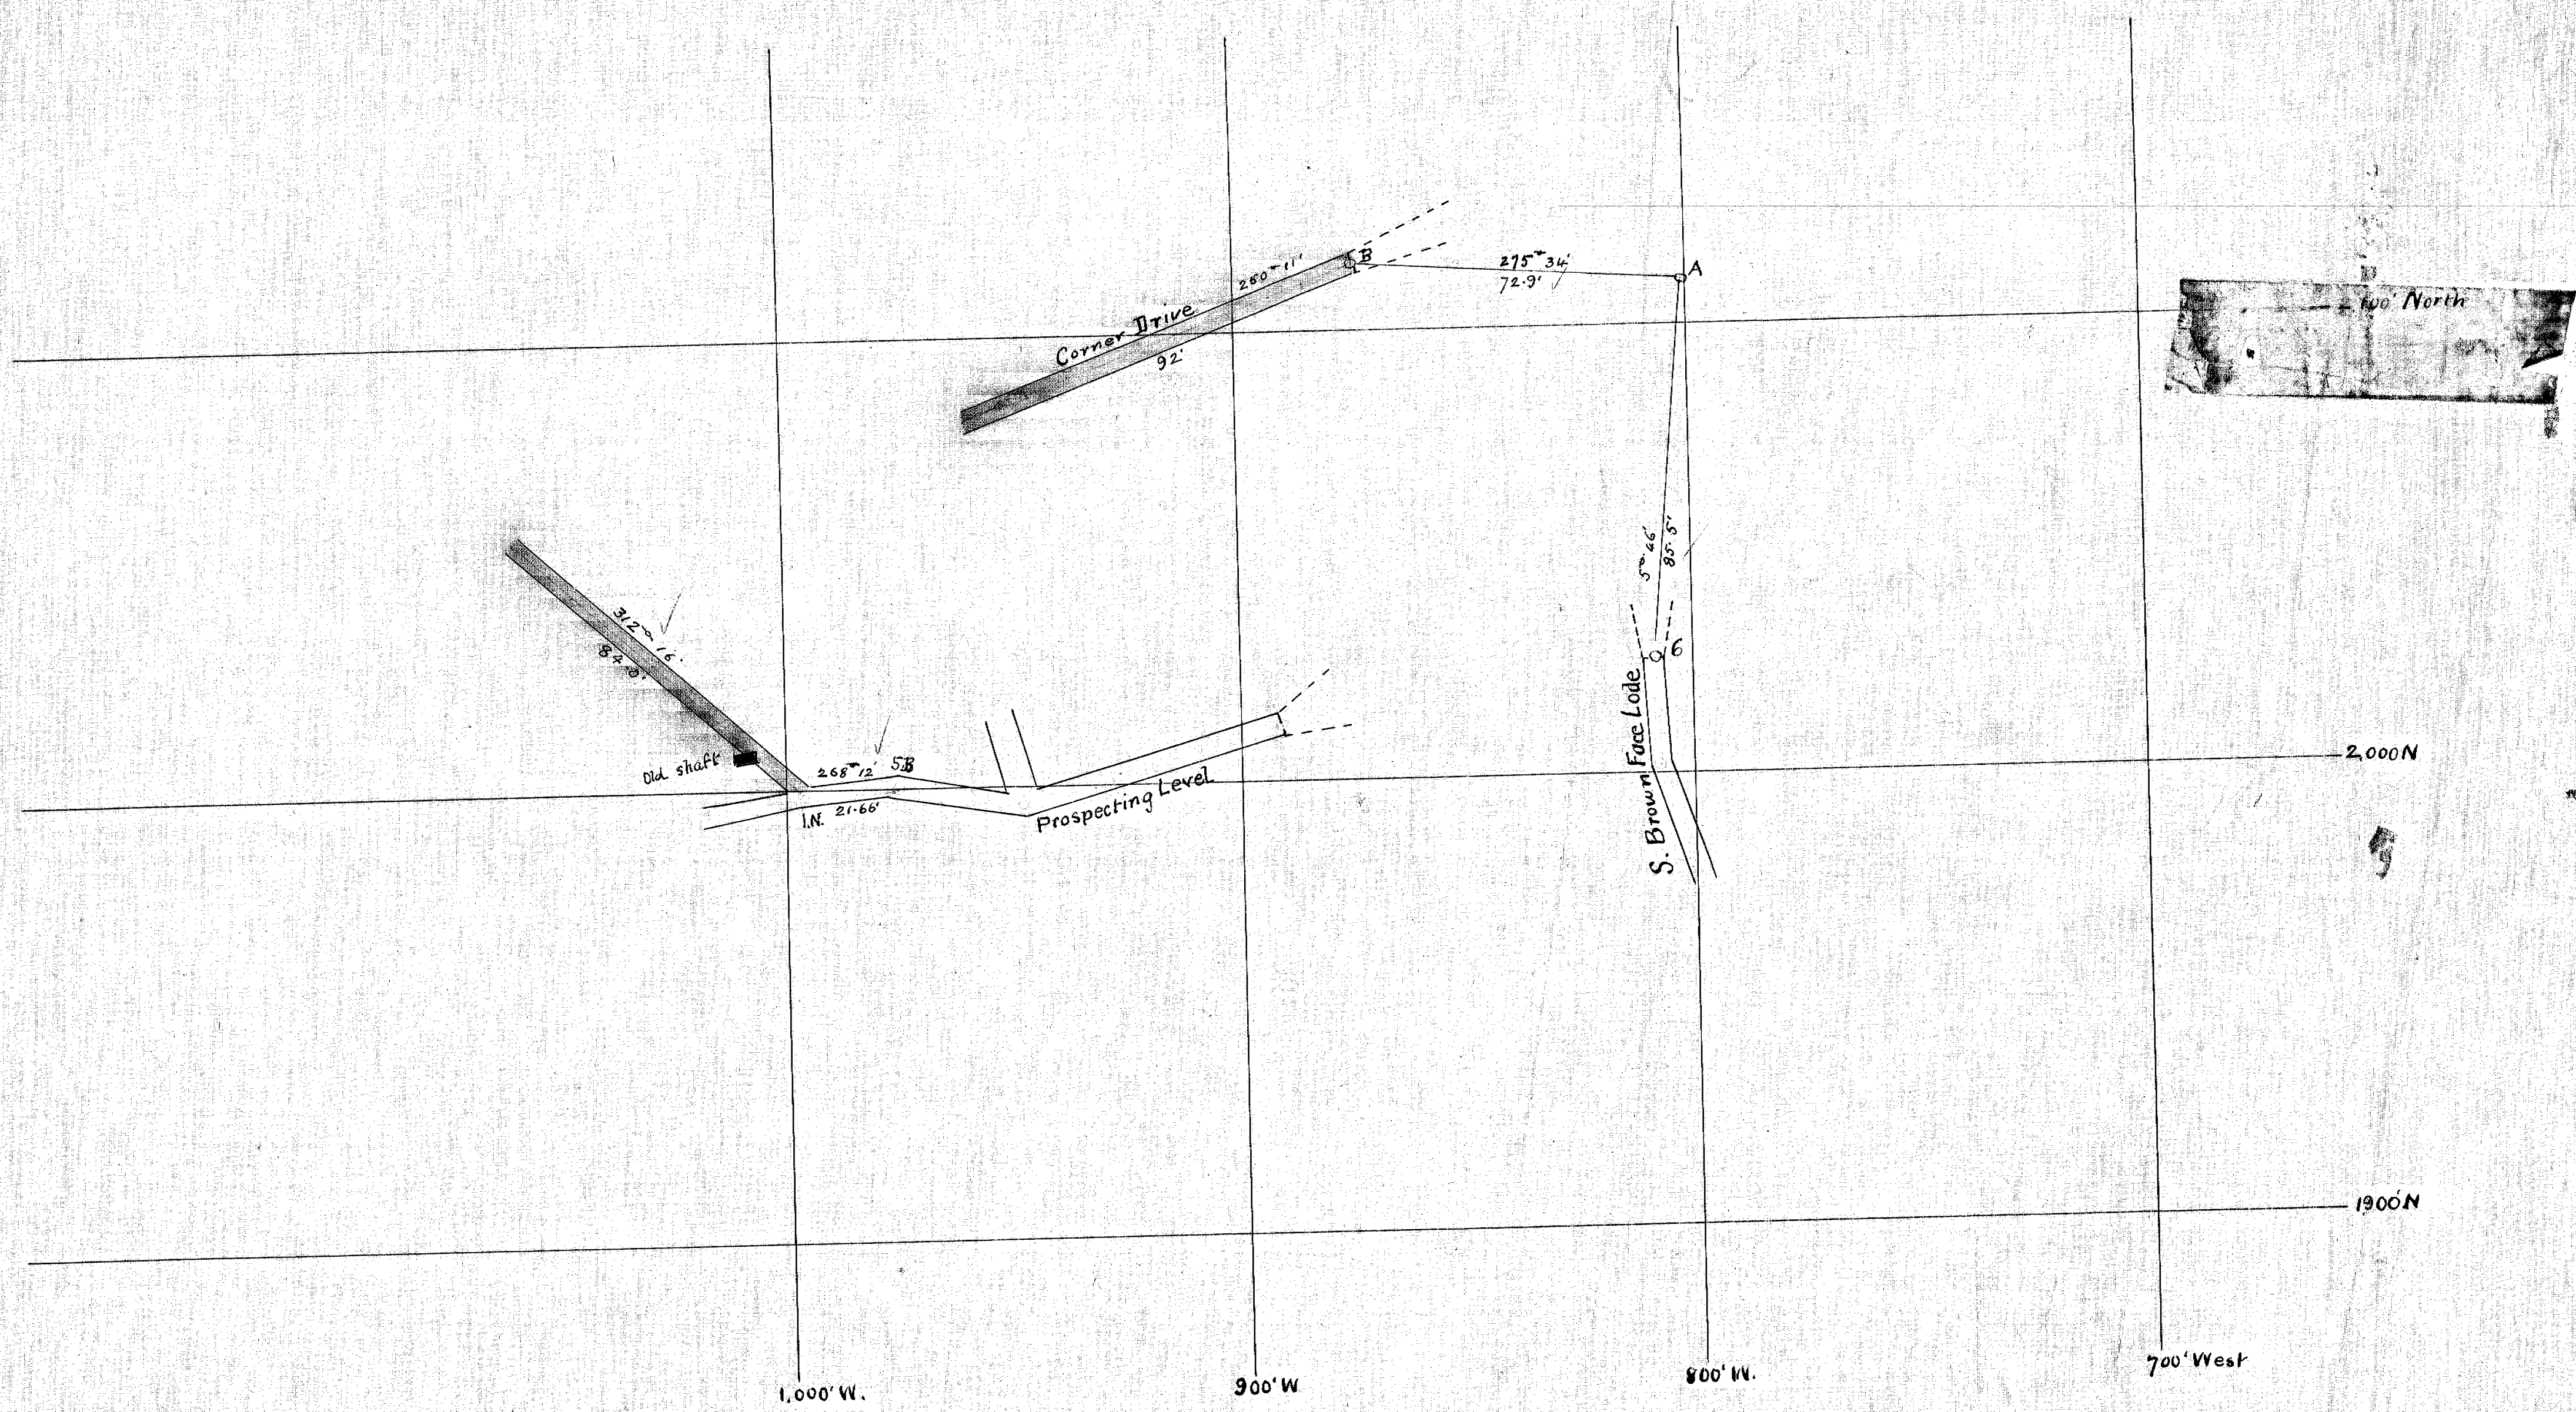

J. H. Loring
Surveyor.

Ed
11/1/29

5 cm

217202