


217-203

217-203

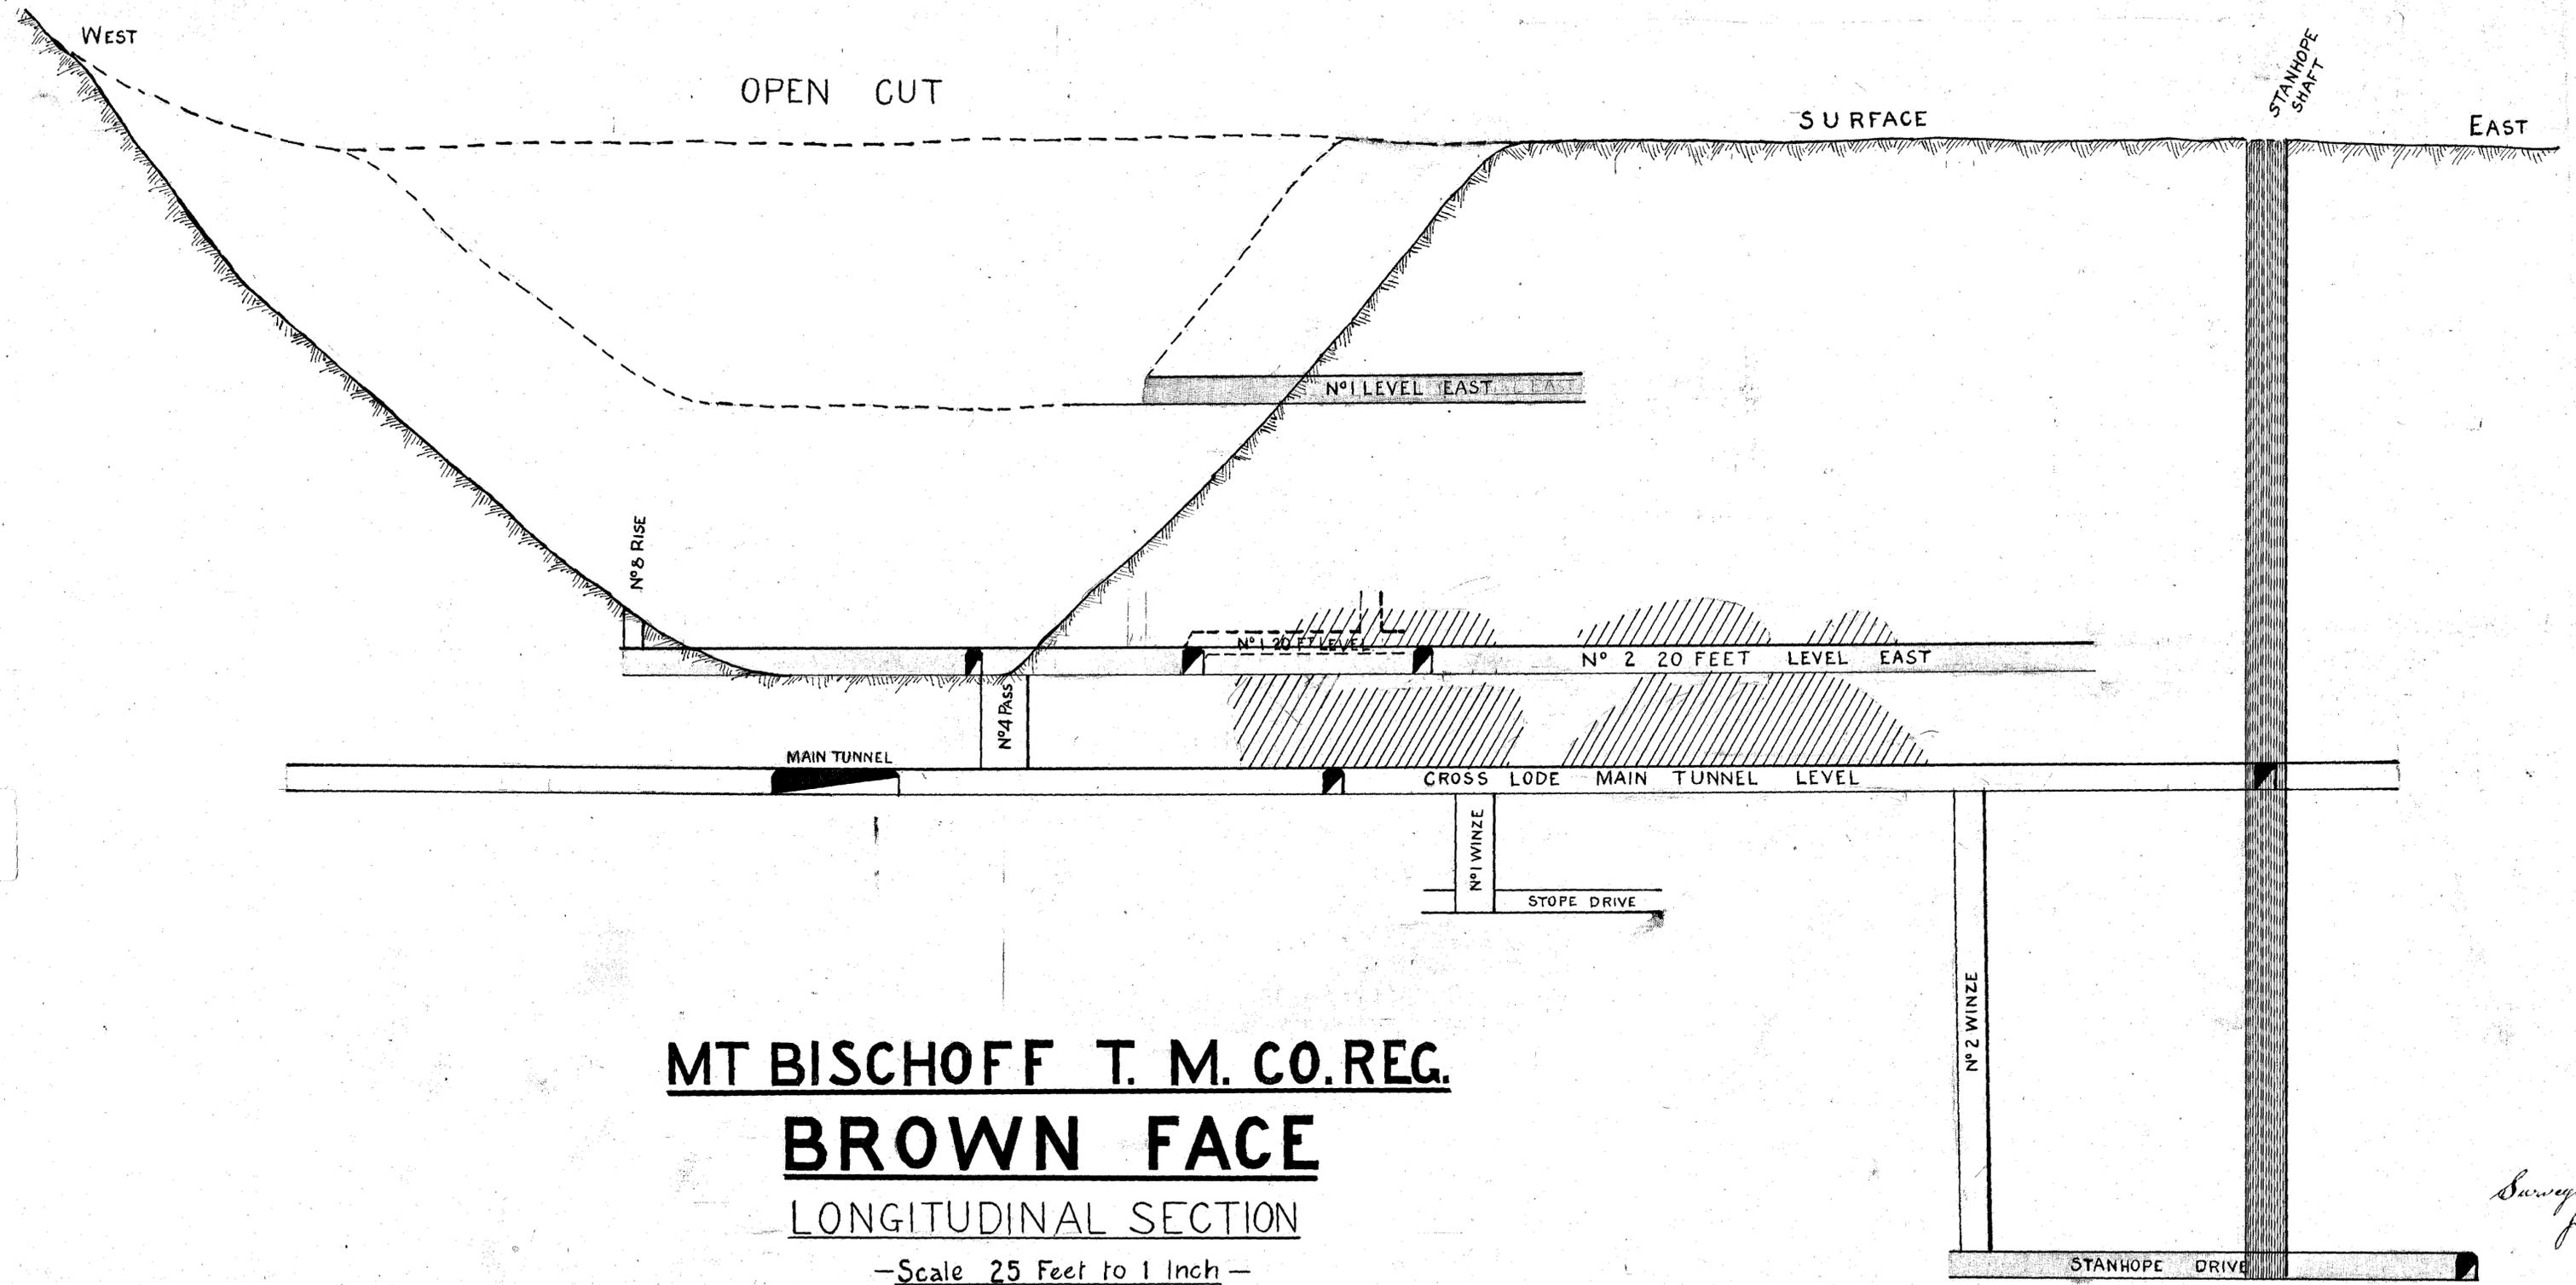

**MT BISCHOFF T. M. CO. REG.**  
**BROWN FACE**  
 LONGITUDINAL SECTION

—Scale 25 Feet to 1 Inch—  
 Dec. 1926.

*Surveyor*  
*J. H. Loring*  
 3/2/27