

217-204

- MT BISCHOFF T. M. CO. REG. -

- BROWN FACE -

Scale 25 Ft to 1 Inch

*With additions (see reference)
to Dec. 31, 1923.
W.A. Carvill
7 & 24.*

H 2200

T

R 2100

D

N 2000

1800

2200

2100

2000

1900

1000

900

800

700


600

W

E

S

T

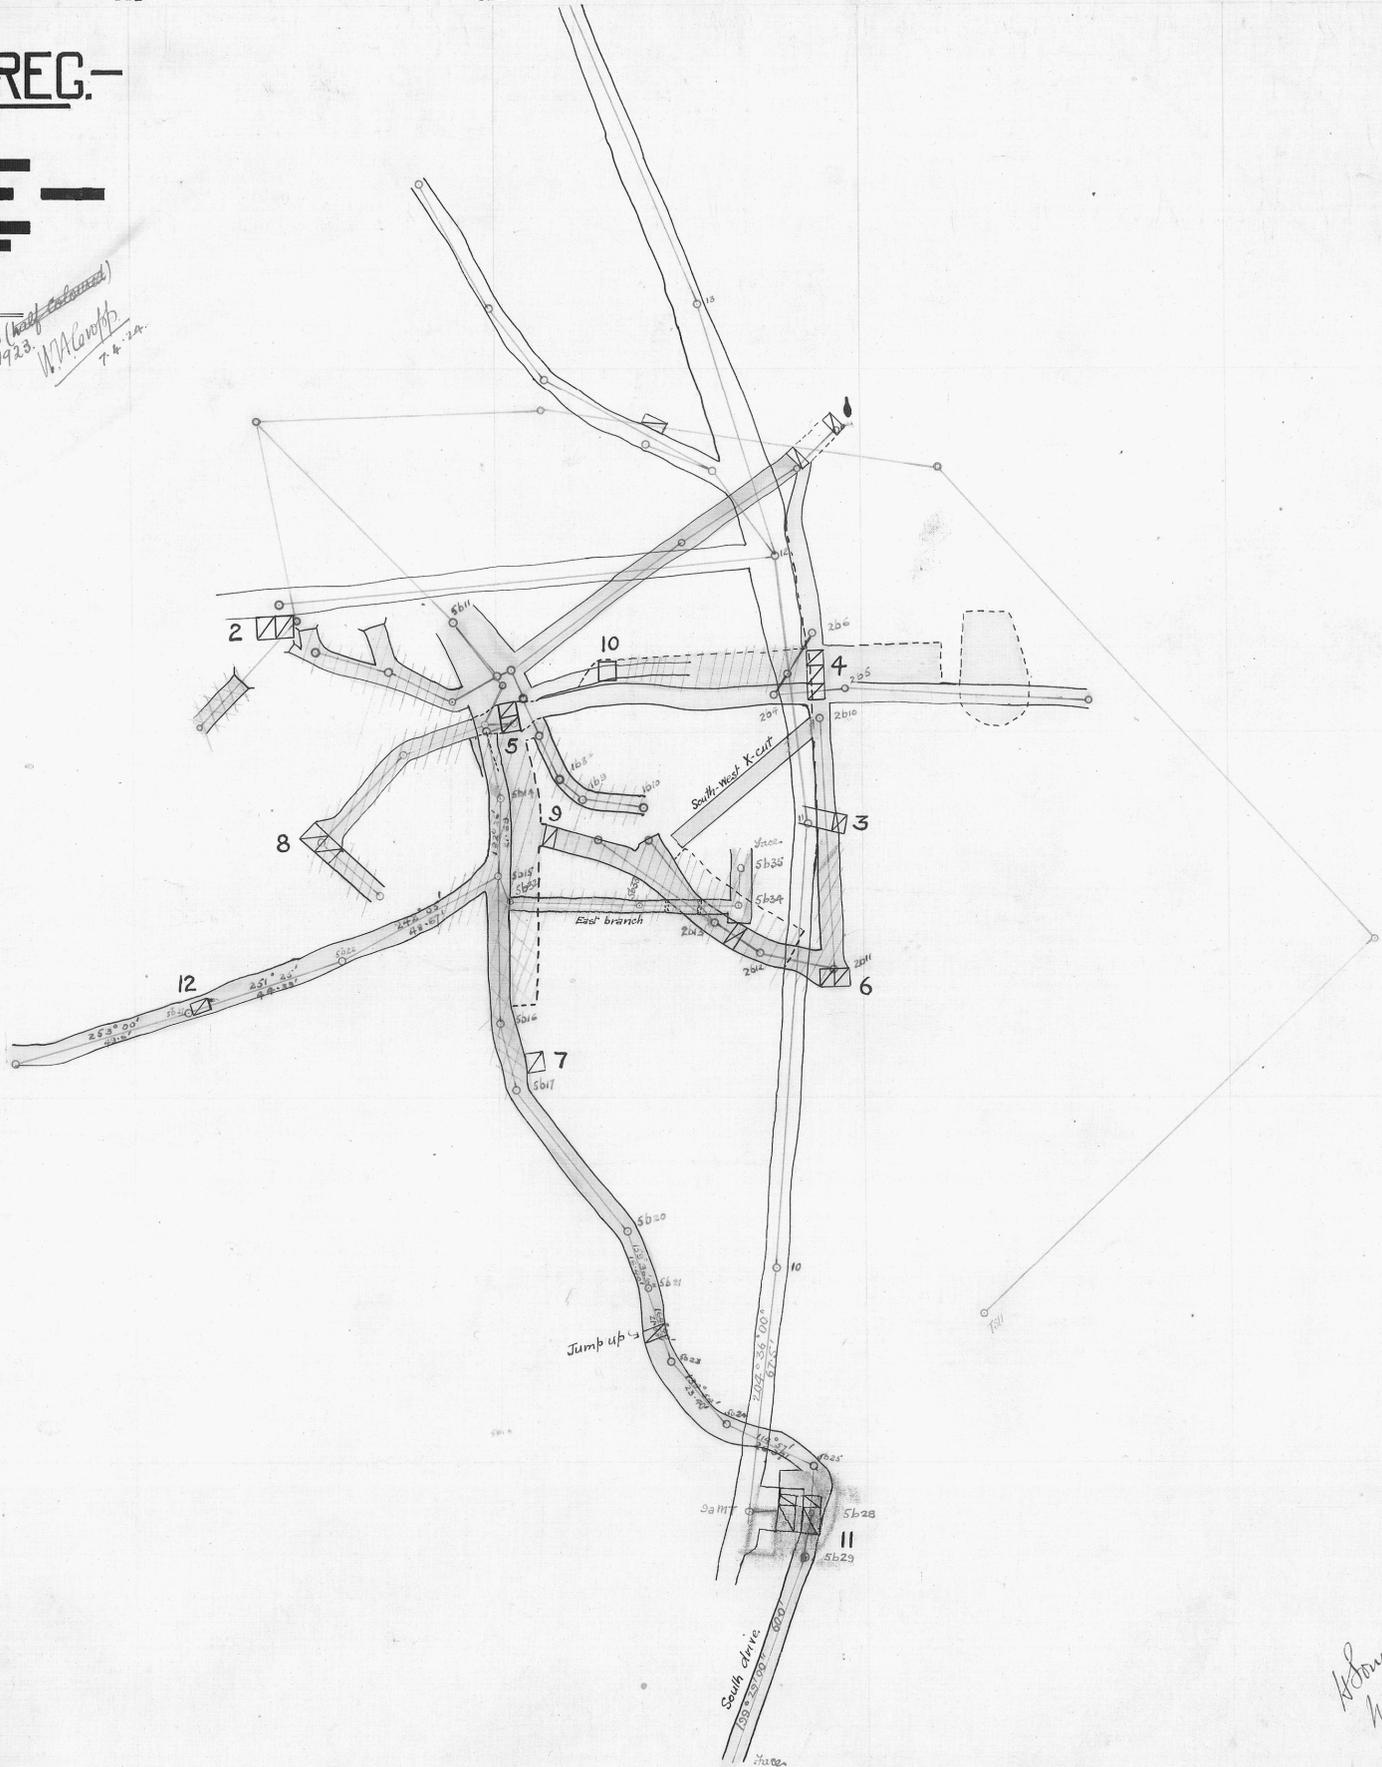

217-204

5 cm

*Homer Williams
Mine Surveyor
2-3-23*

4-1-23