

MT BISCHOFF T.M.CO.REG.

GOSSAN FACE LODGE






— LONGITUDINAL SECTION —

— SCALE 25 FT TO 1 INCH —

217-207

5 cm

217-207

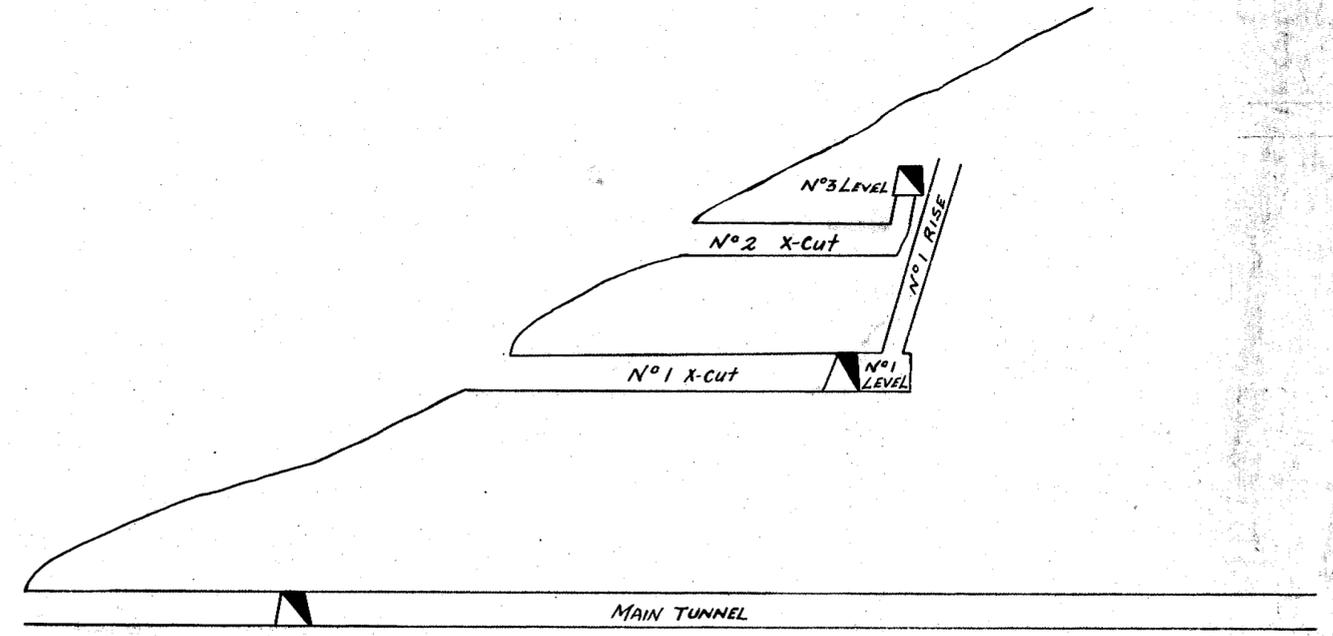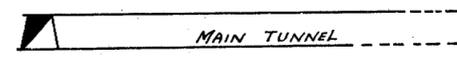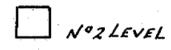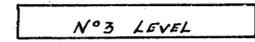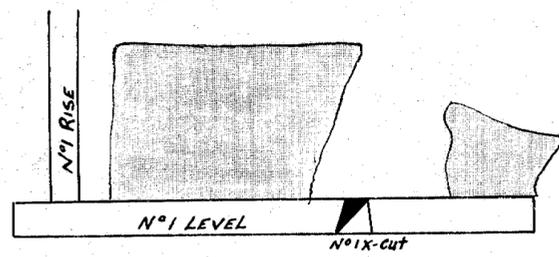

TRANSVERSE SECTION

WORK 1939
SURVEYOR A.T. Pette
INSTRUMENT USED 5" THEODOLITE

6/5/40