


— MT BISCHOFF T. M. CO. REG —

— COSSAN FACE WORKINGS —

— SCALE: 25 F" TO 1 INCH —

217-208

Ed
10/22/34

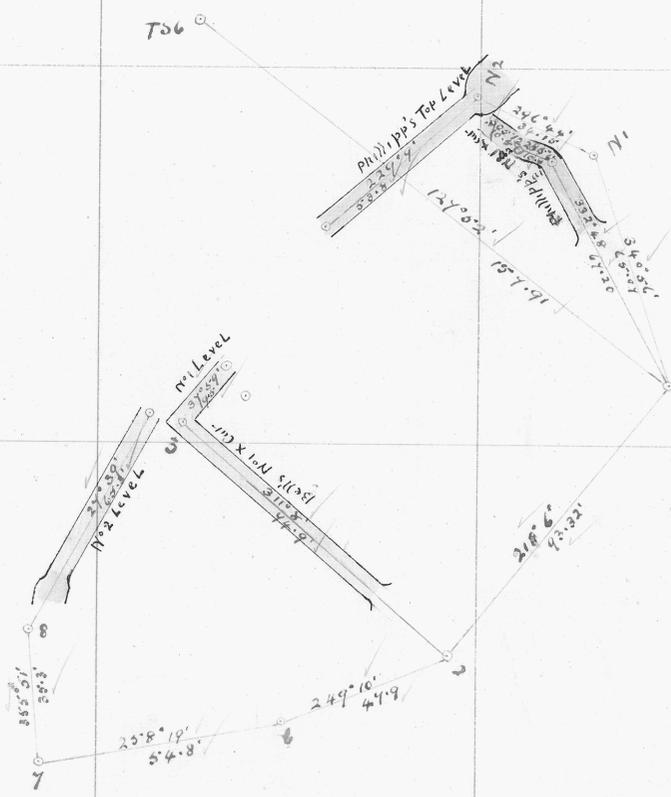

LINE A

LINE B

217-208

1700 W

1600 W

1500 W

1400 W

1300 W

1200 W

1100 W

1000 W

COSSAN



Work 1933
Surveyor W. H. Dorr
Instrument used 5" Theodolite