


— MT BISCHOFF T M CO REG —

— GOSSAN FACE LODE —

Scale 25 FT to 1 Inch

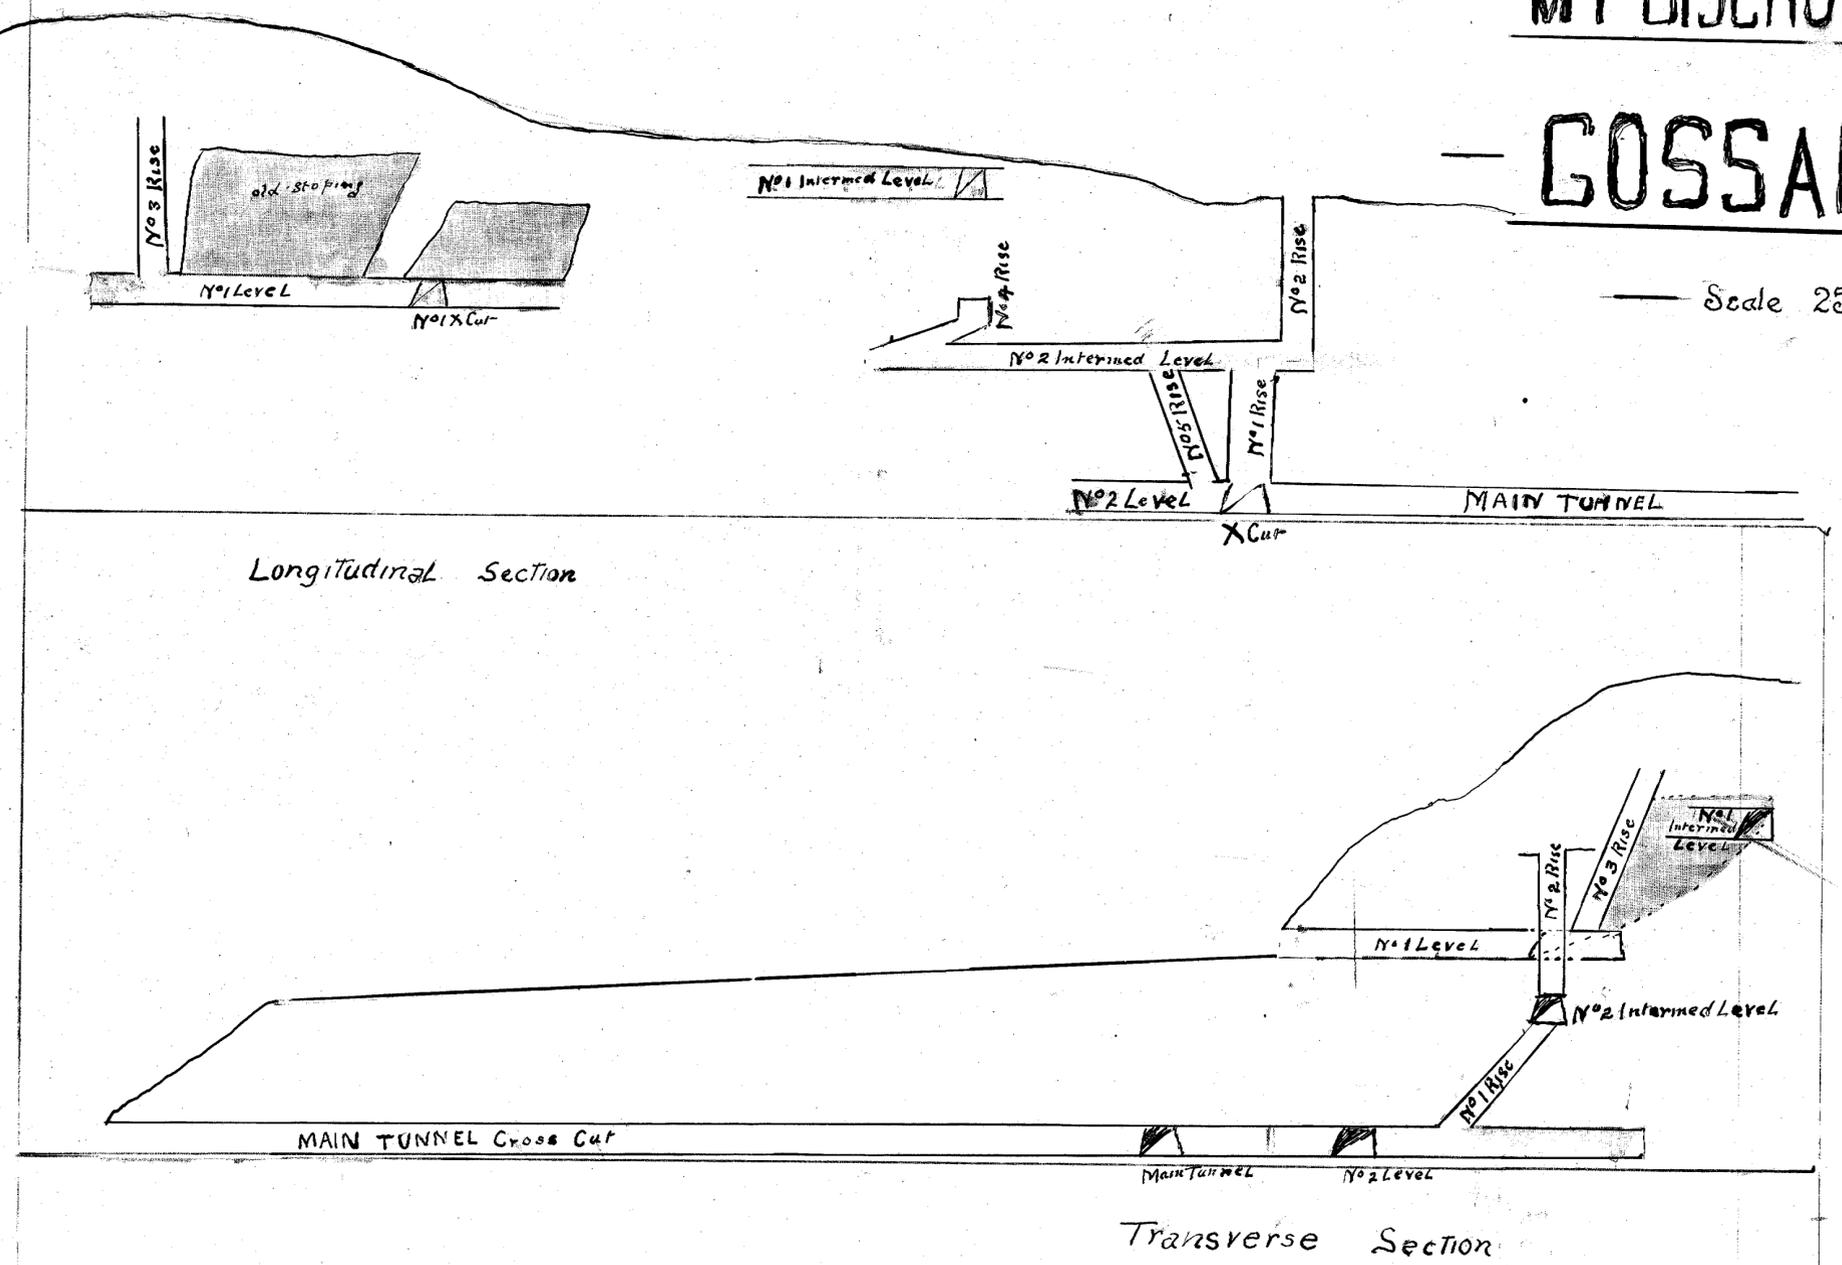

217-209

Gossan Lenses

217-209

W. B. D. M.
10/3/22