
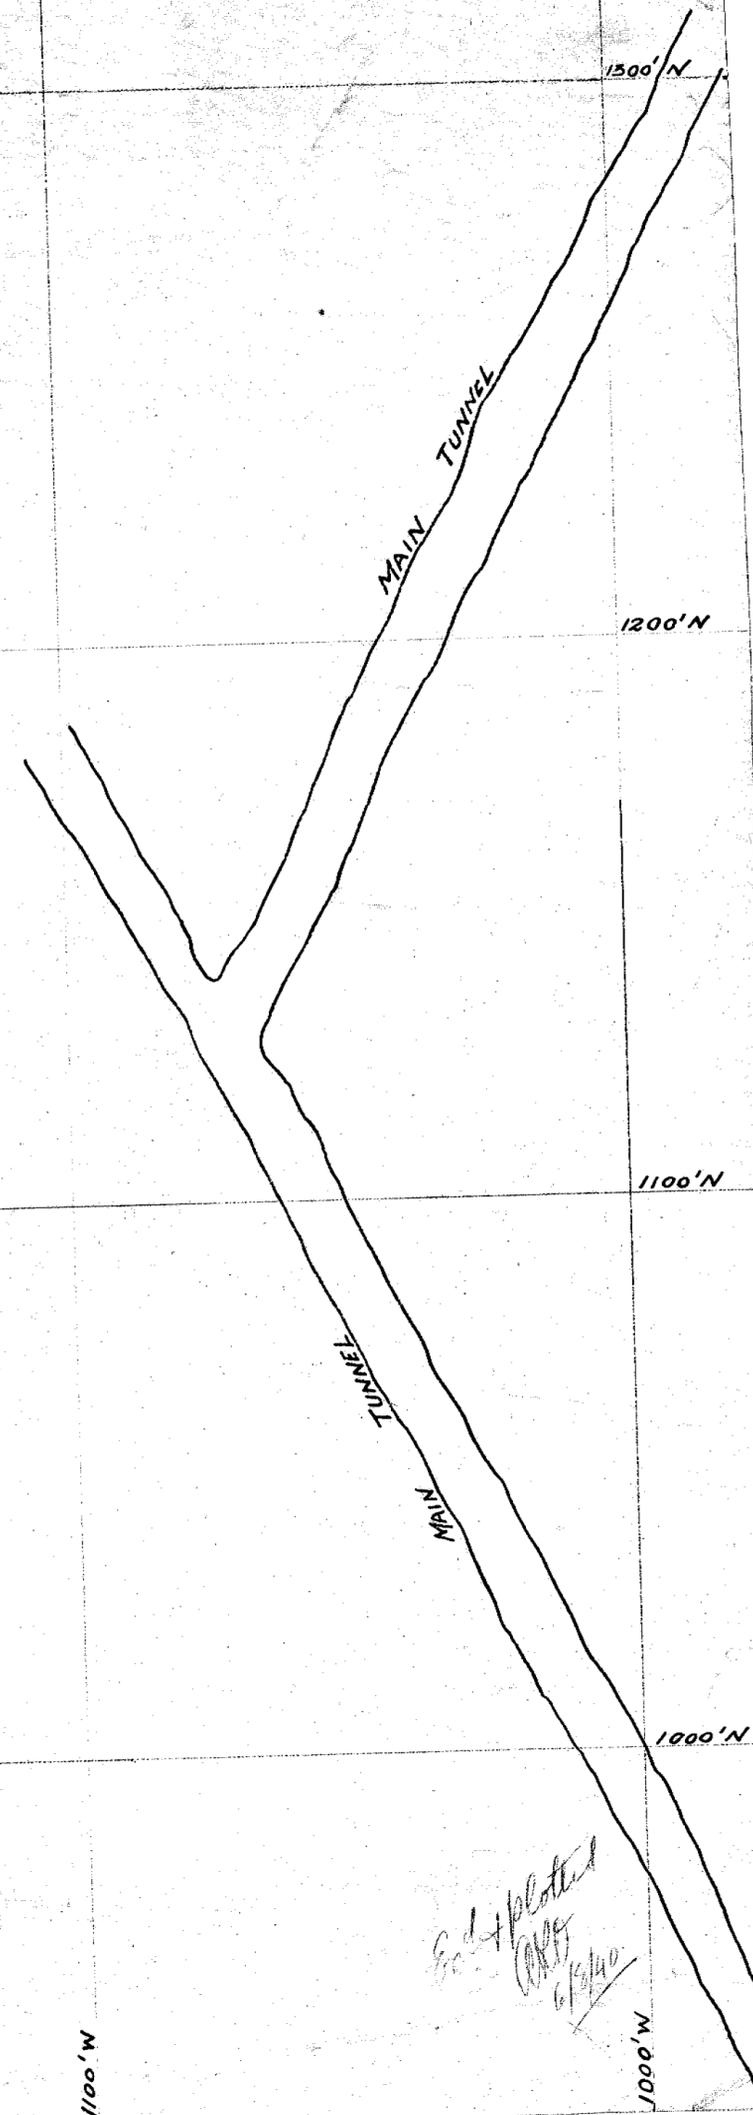


MT BISCHOFF T.M.CO.REG.


GOSSAN FACE LODGE

— SCALE 25 FT TO 1 INCH —

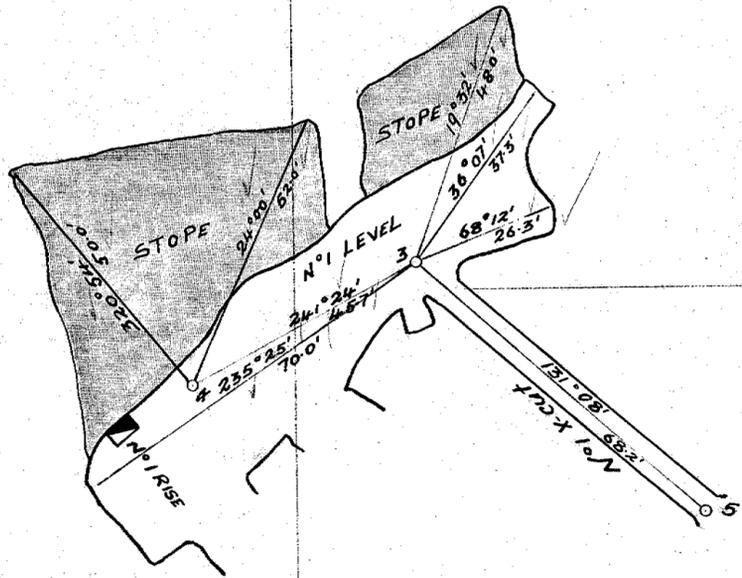

217-210

217-210

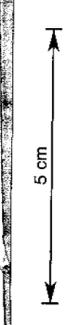

WORK 1939
SURVEYOR G. J. Bate
INSTRUMENT USED
5" THEODOLITE

M. 0. 0. 21

1200' W

1100' W

1000' W