


GOSSAN FACE LODE

SCALE 25 FT TO 1 INCH

217-212

217-212

W. L. Doster
10th March 1942

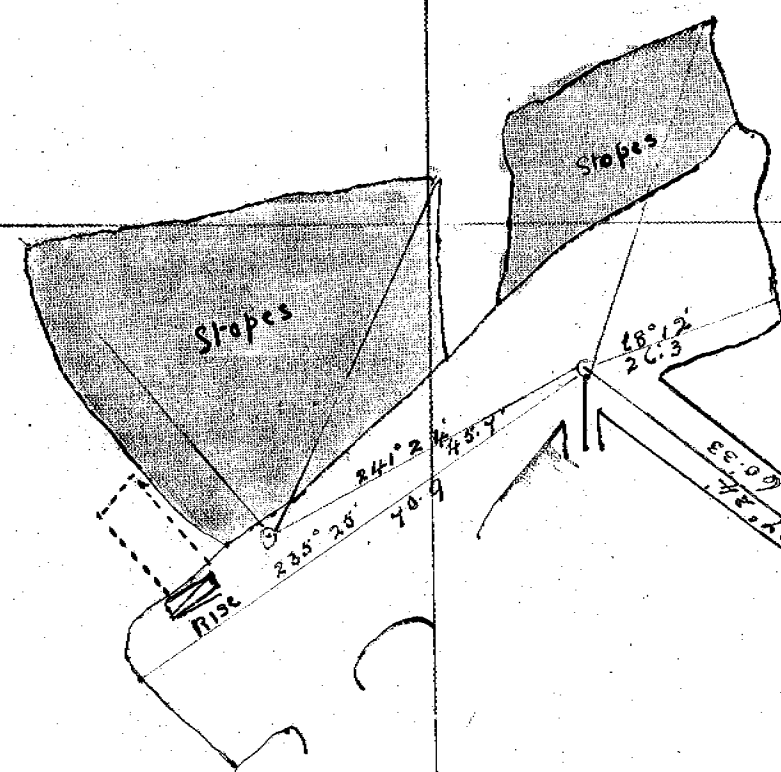

Section

