


MT BISCHOFF T.M.CO.REG.


KEYSER LODE

LONGITUDINAL SECTION

— SCALE 25 FT TO 1 INCH —

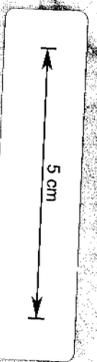

217-213

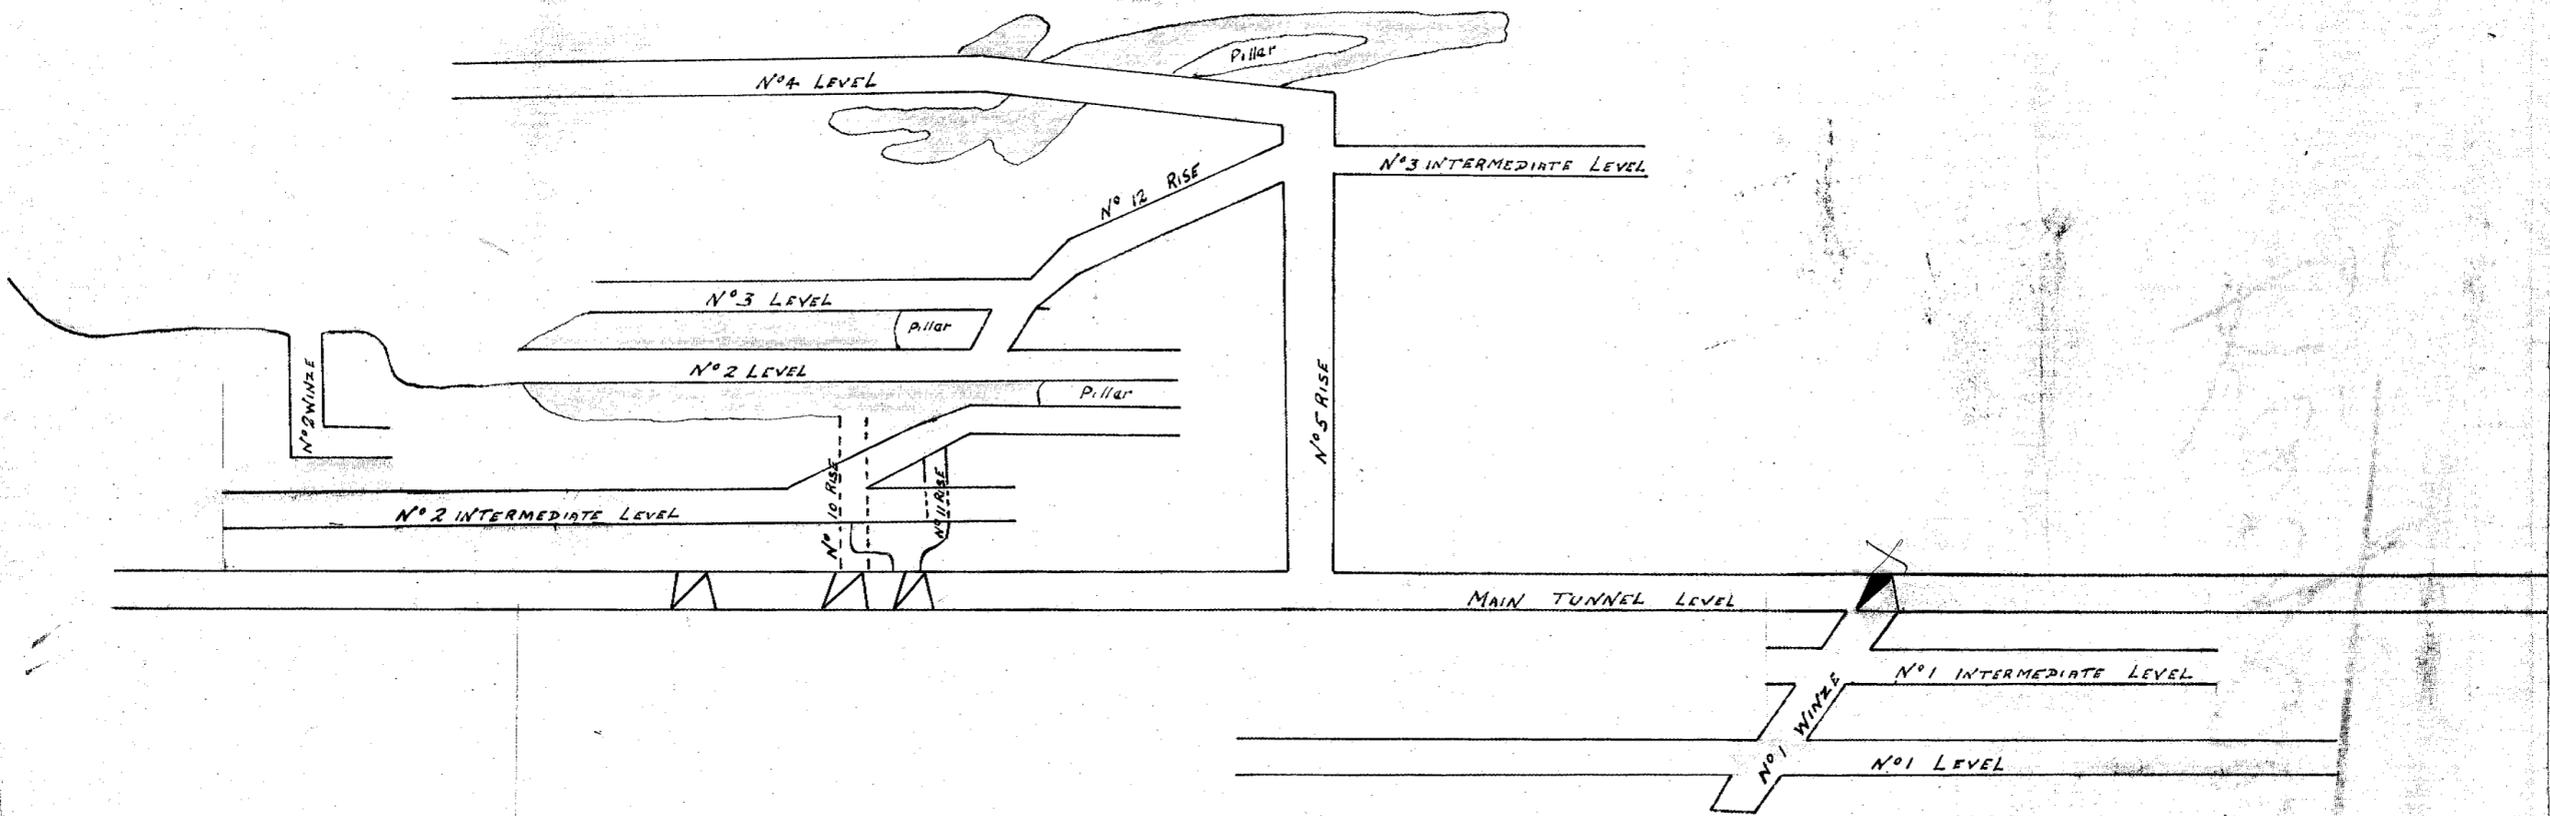

217-213

Work 1905-
Surveyor M. H. Dork
but used 5" theodolite