


MT BISCHOFF T.M.CO.REG.

KEYSER LODGE


TRANSVERSE SECTION

SCALE 25 FT TO 1 INCH

217-216

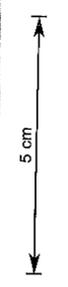

217-216

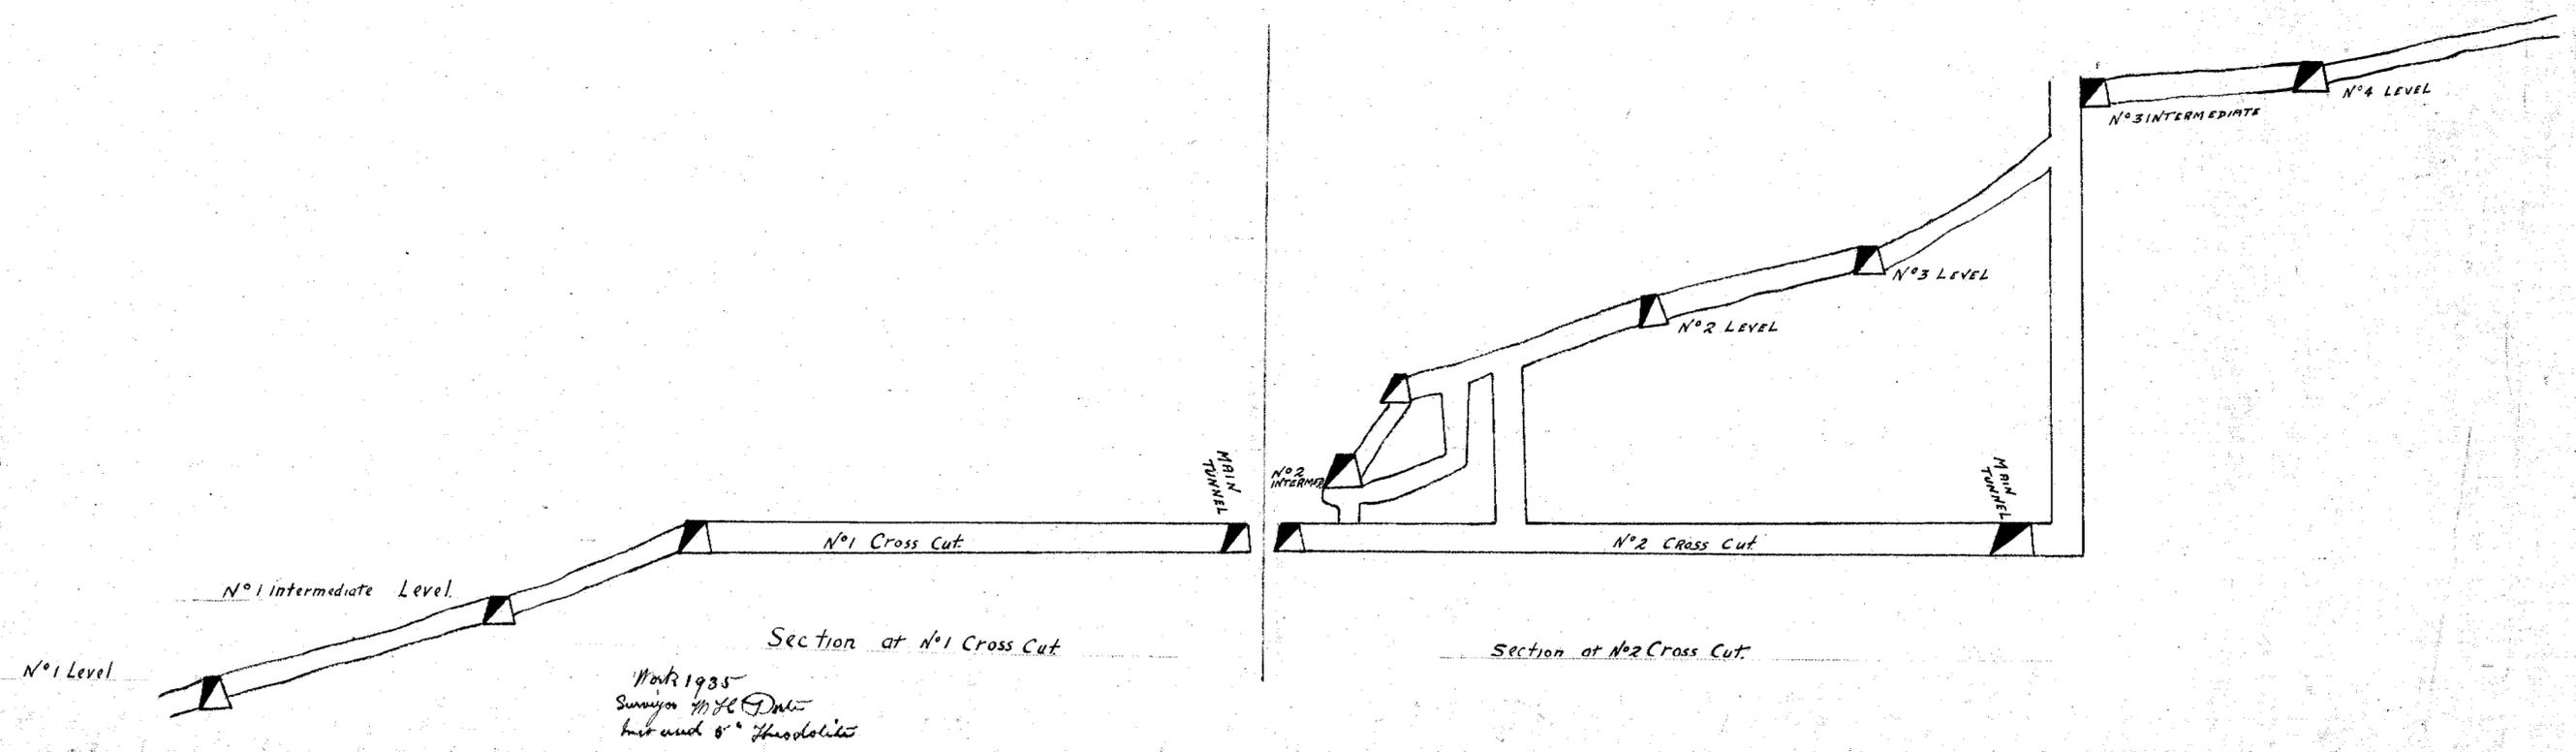

Handwritten signature or initials