
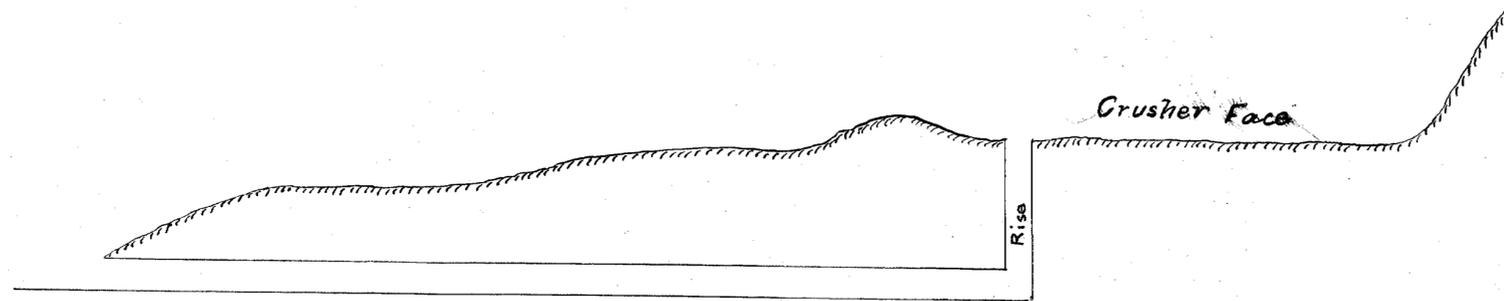



MT. BISCHOFF T. M. CO. REG.

DRAINAGE TUNNEL

Scale: 25' to 1"

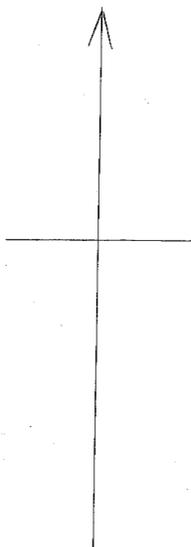

SECTION.

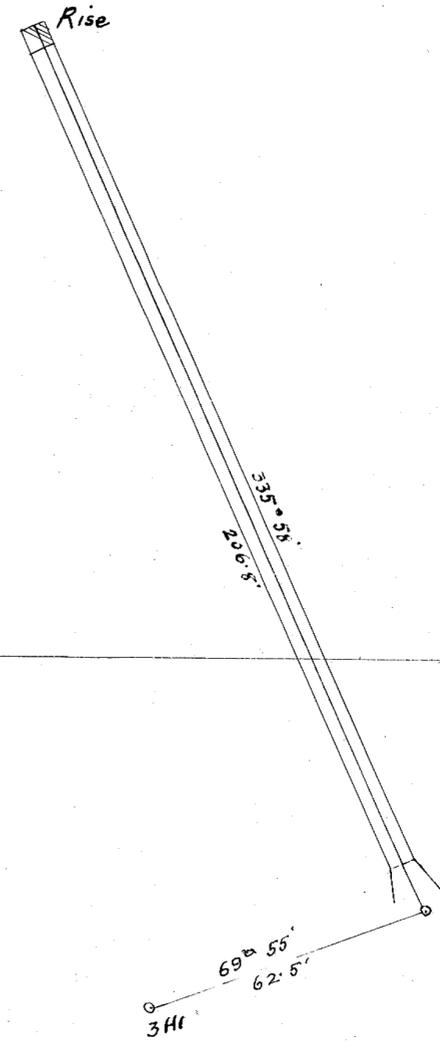

PLAN

Surveyor - J. H. Lewis  
Int. and 4" theodolite  
Dec. 31<sup>st</sup> 1927.

217-217

217-217

5 cm