


Mt. BISCHOFF T. M. Co. Reg.

SLAUGHTER LODES


WORKINGS TO DEC. 31 1923.

T.S. SCALE 25 FT. TO 1 IN.


*W.P. Gossan
By J. W. Gossan
25-3-24.*

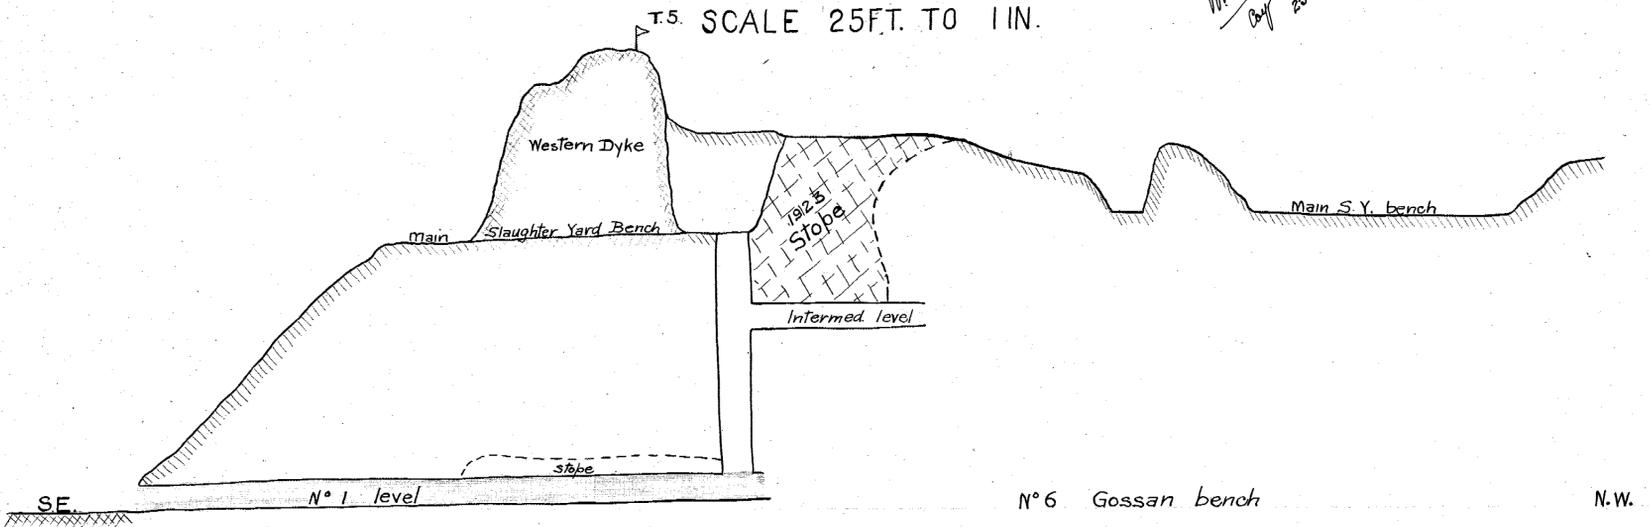


LONGITUDINAL SECTION

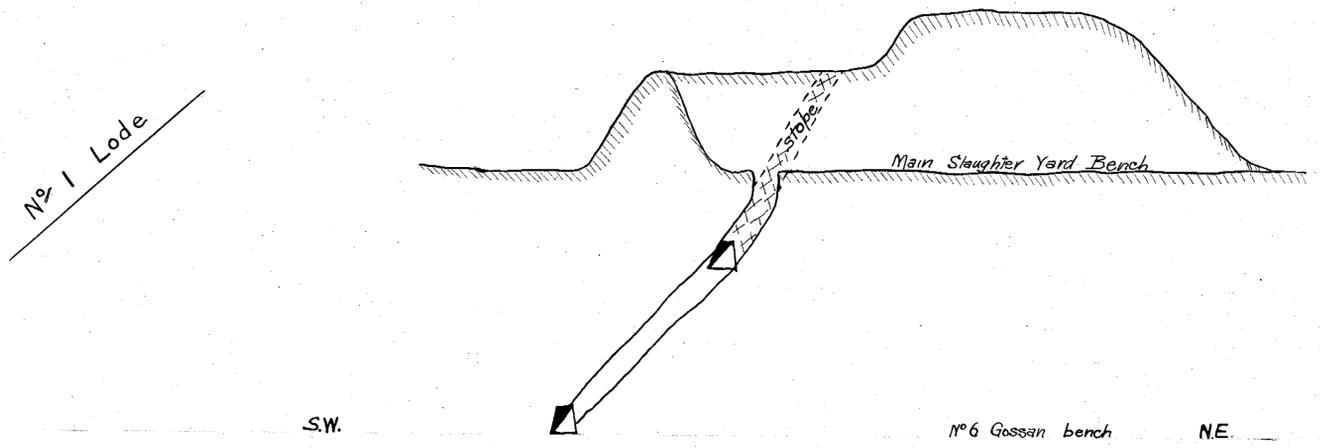

TRANSVERSE SECTION

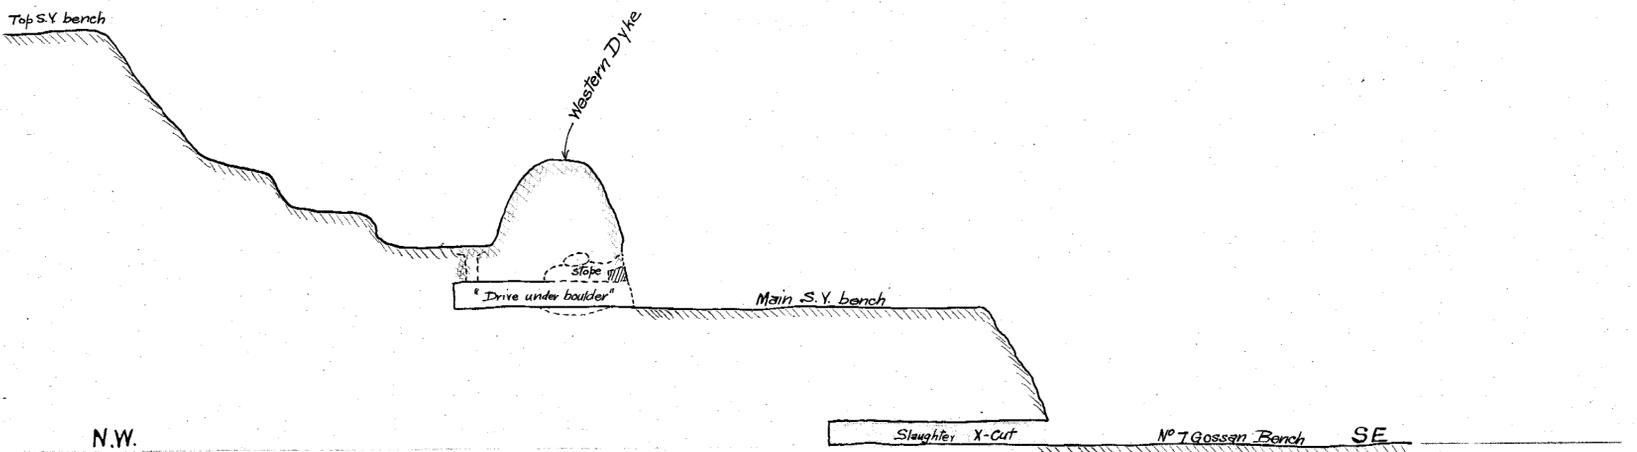

LONGITUDINAL SECTION

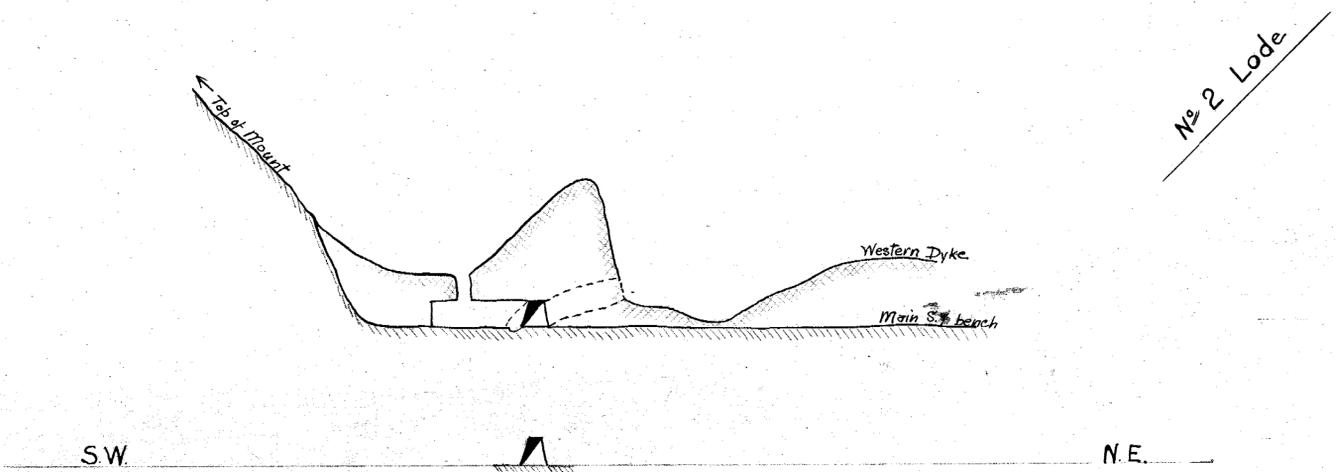

TRANSVERSE SECTION