


—MT. BISCHOFF T. M. CO. REG.—


—SLAUGHTER LODGE—

—SCALE 25 FT TO 1 INCH—

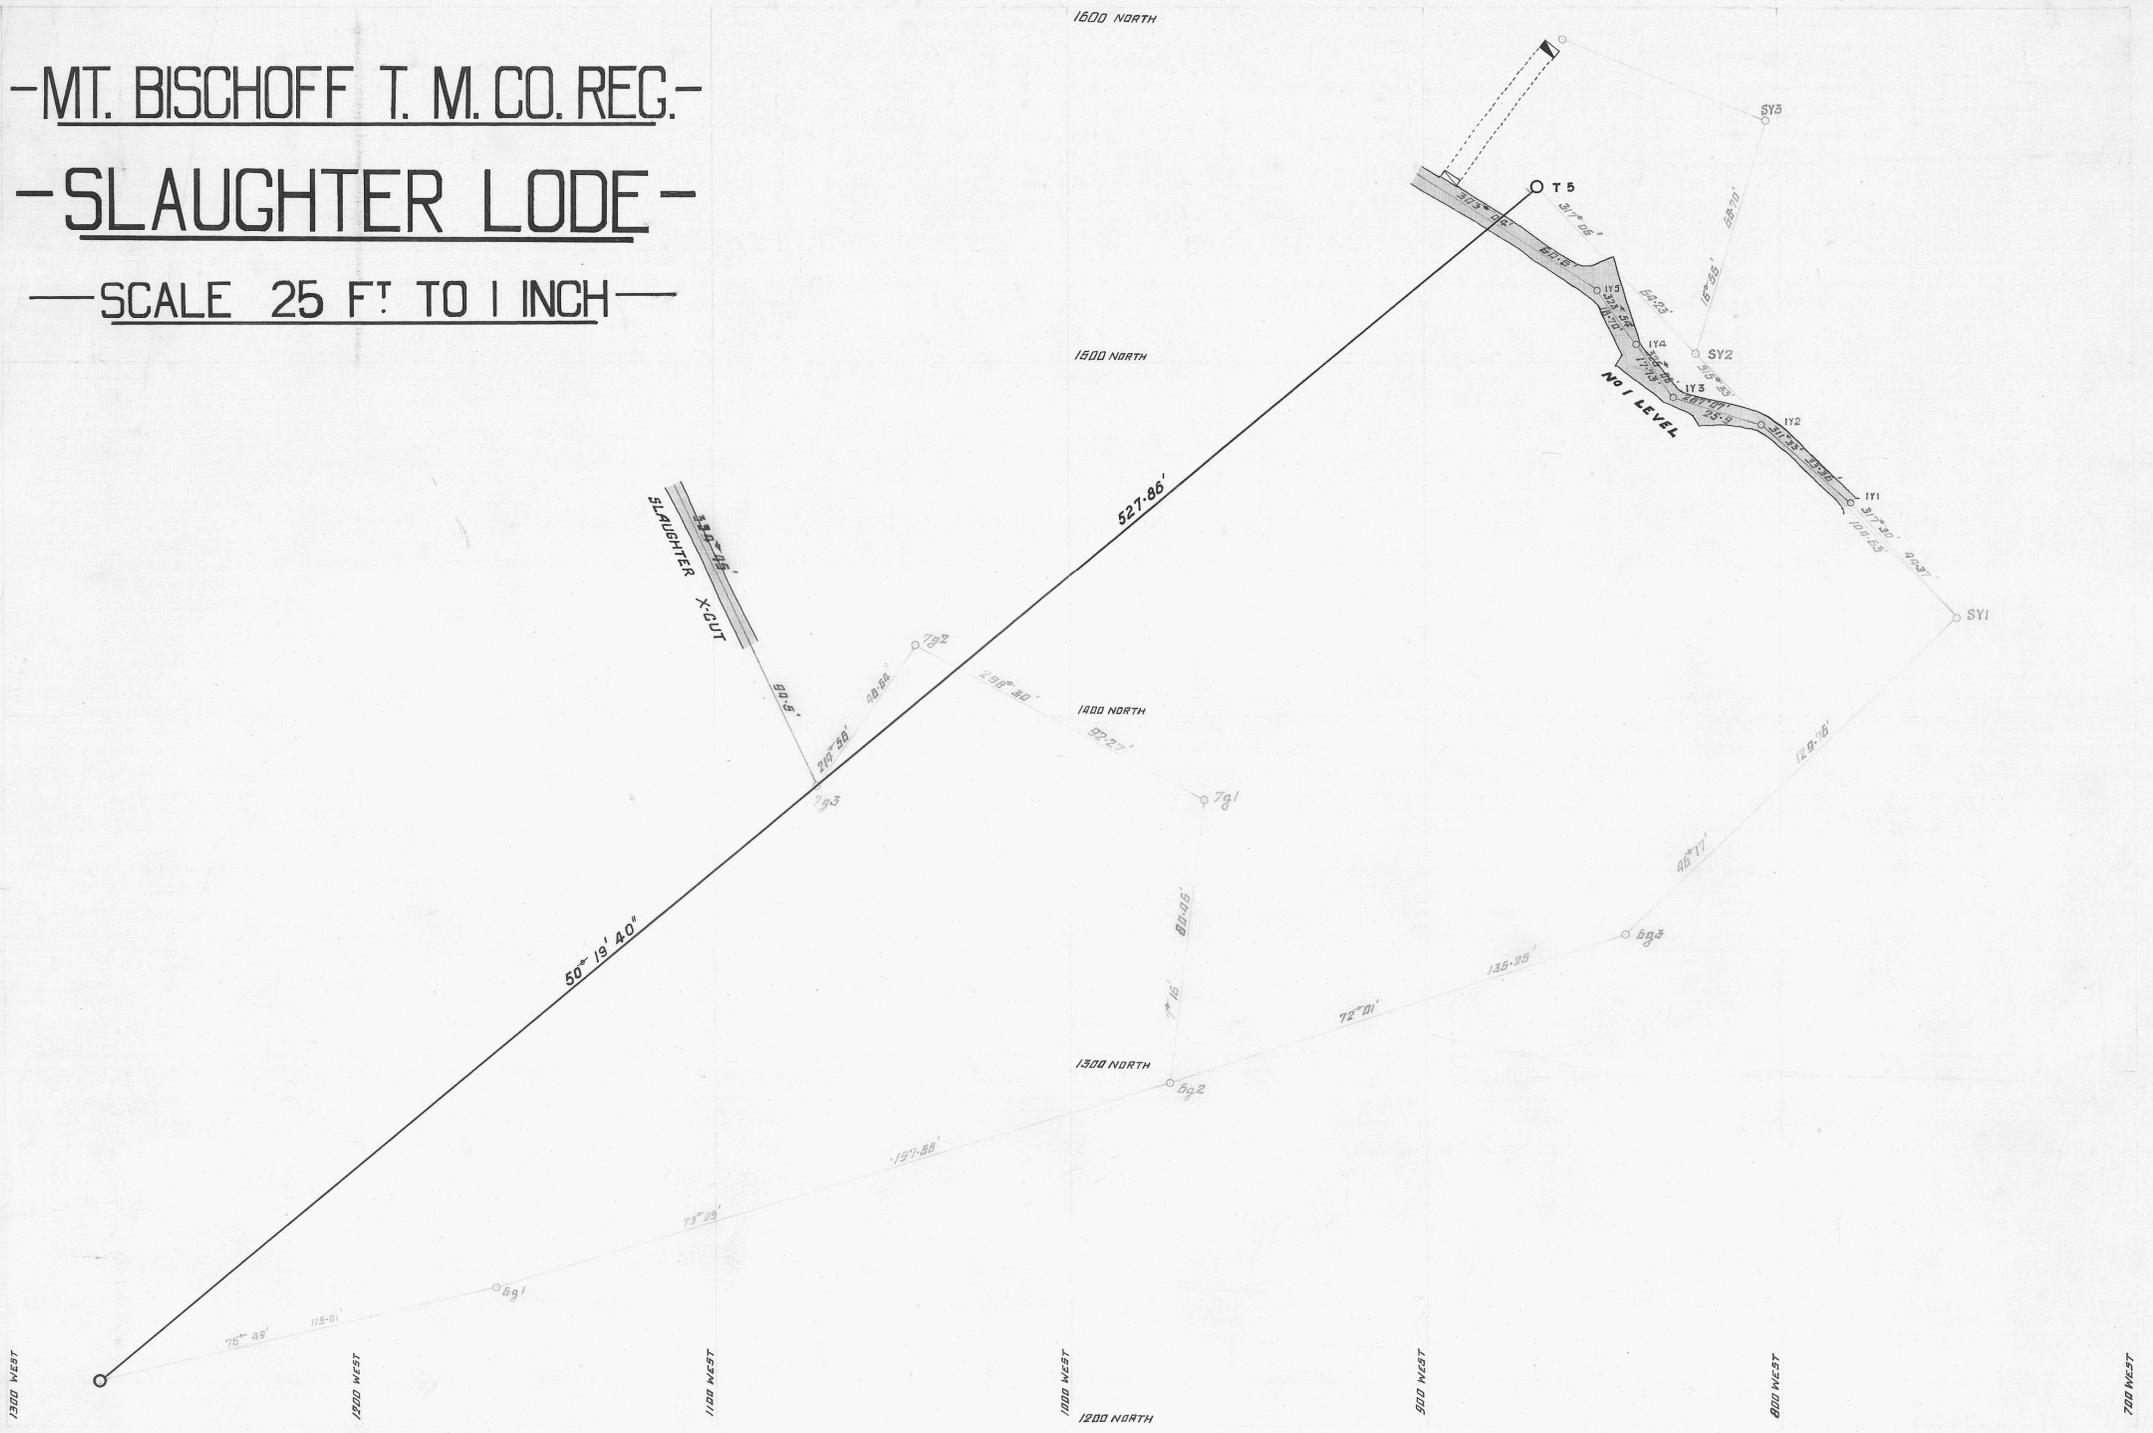

217-219

—PLAN—

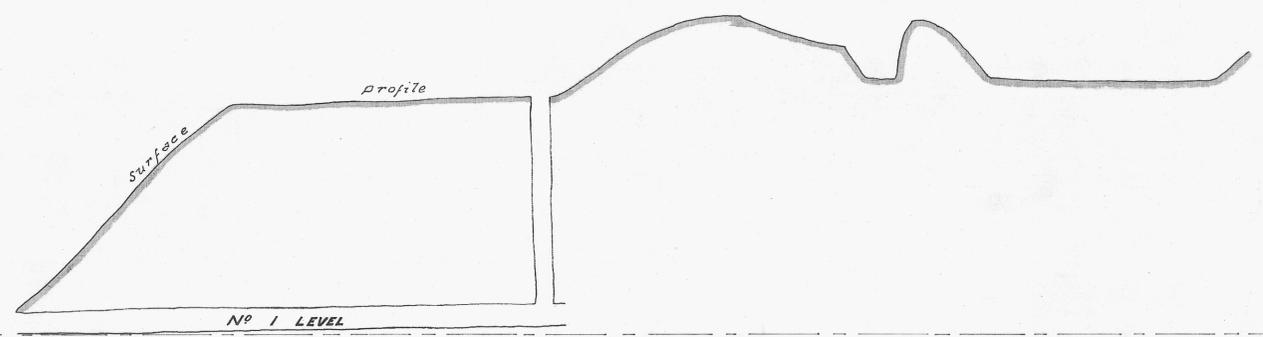

—LONGITUDINAL SECTION—

Honolulu,
Certified Correct Copy
Mine Surveyor
W. H. Anderson General Mine Manager

217-219