



210ndpfcf 1096

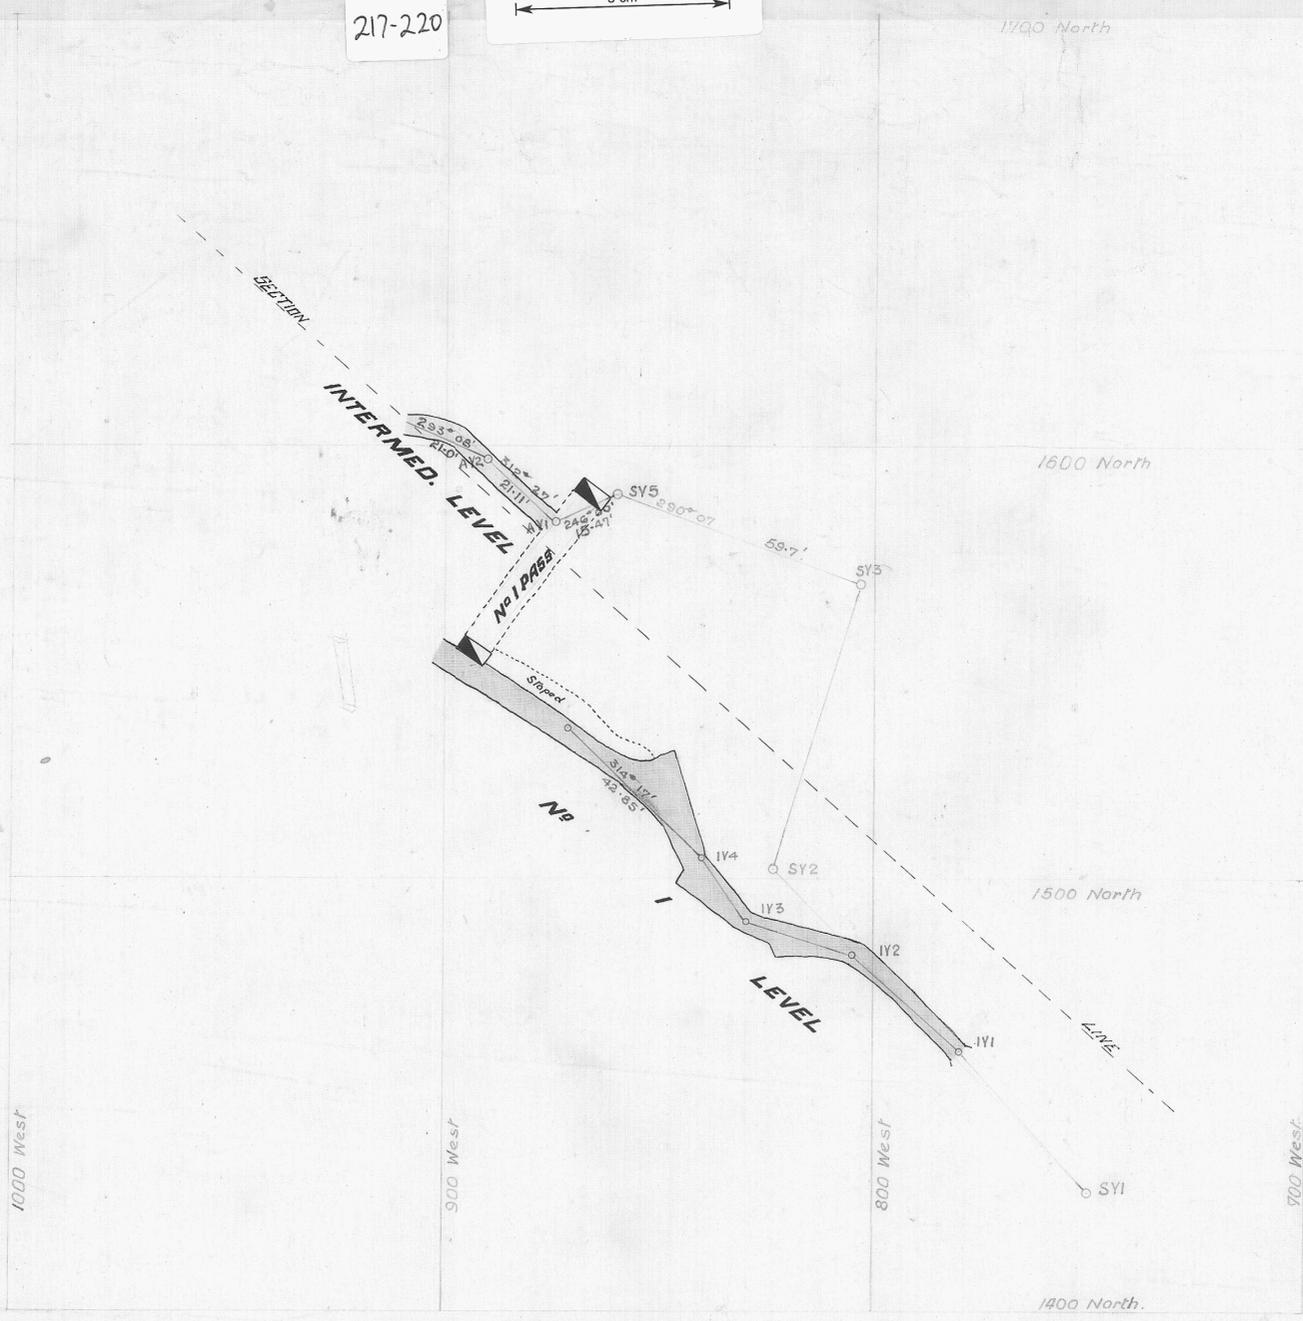


PLAN

— *W<sup>t</sup> Bischoff I. W. Co. Reg.* —  
— **SLAUGHTER LODGE** —  
— SCALE: 25 FT TO 1 INCH —

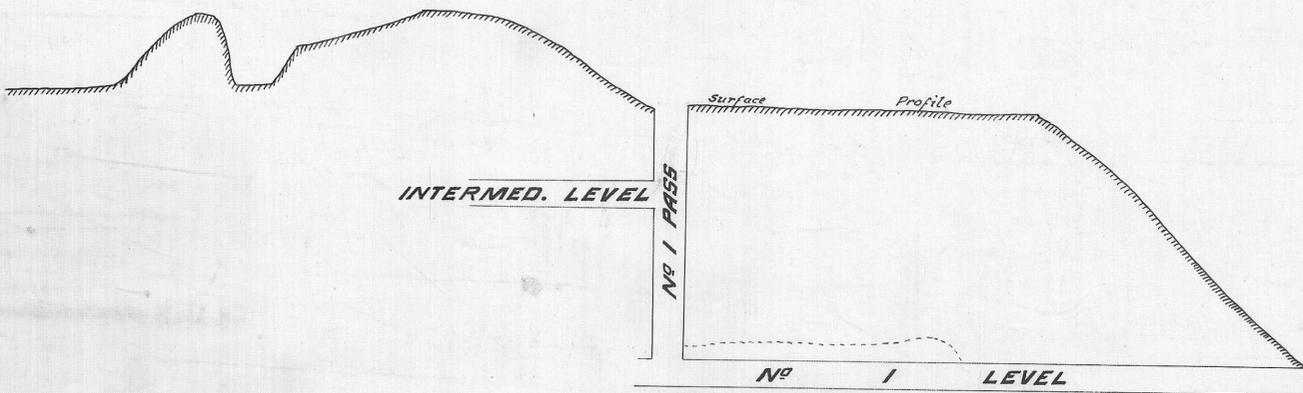

LONGITUDINAL SECTION

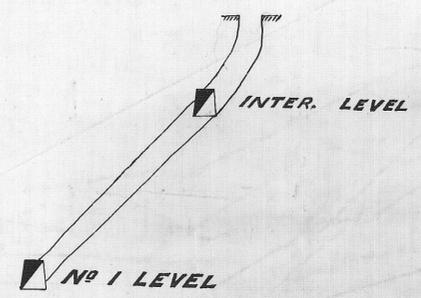

TRANSVERSE SECTION

Exp.  
93  
2-6-22  
Hornsville  
Mine Surveyor  
14-3-22