
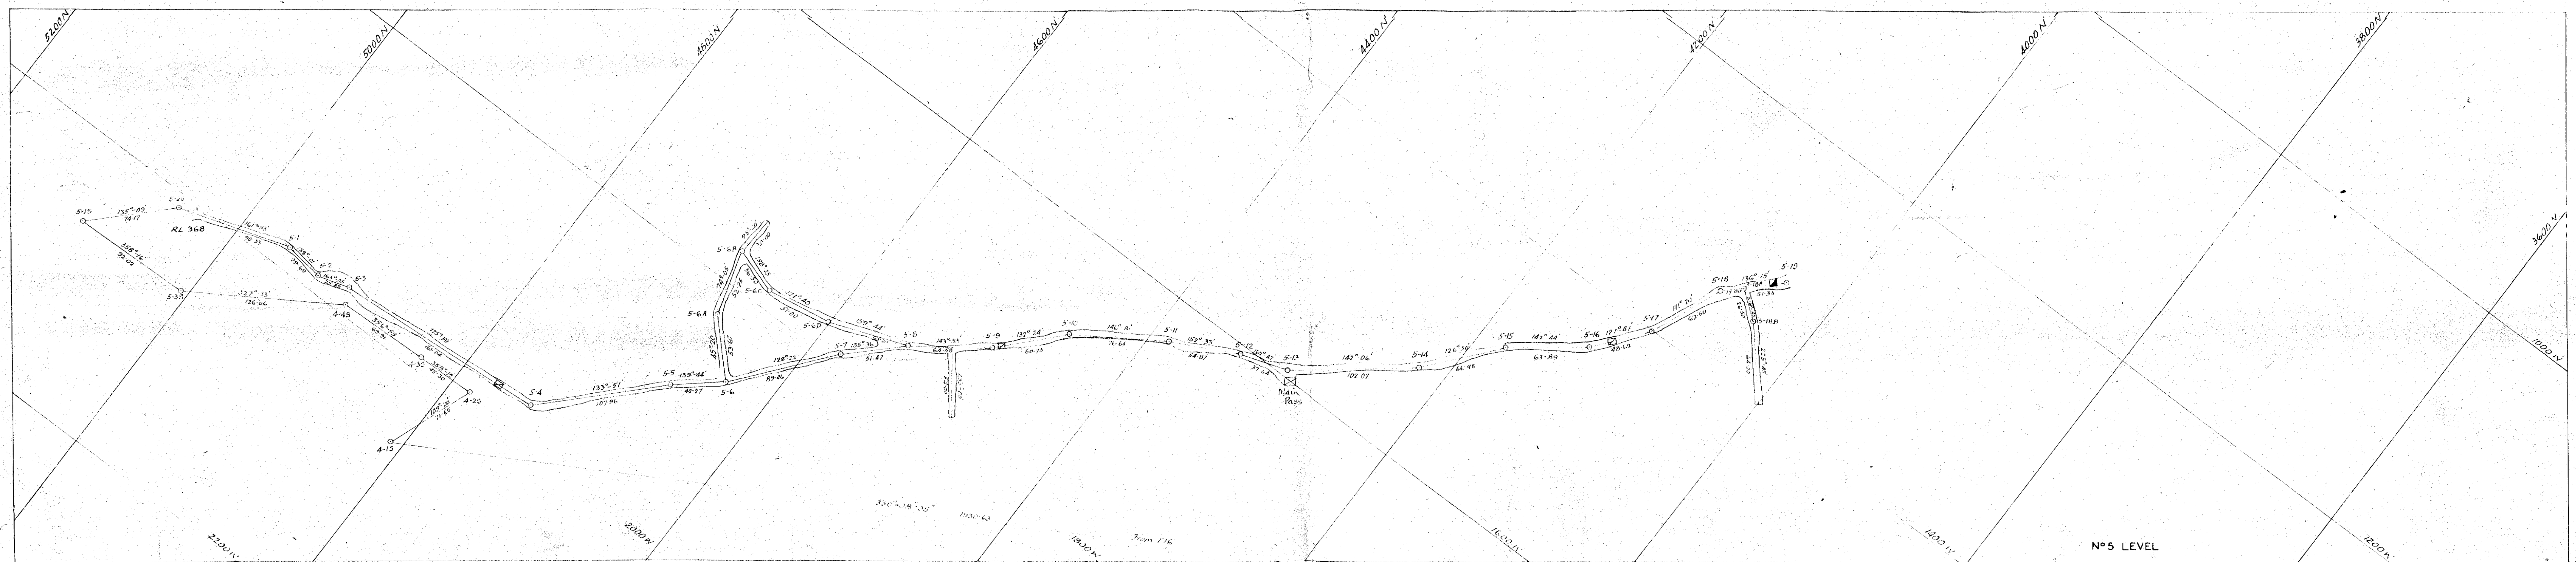
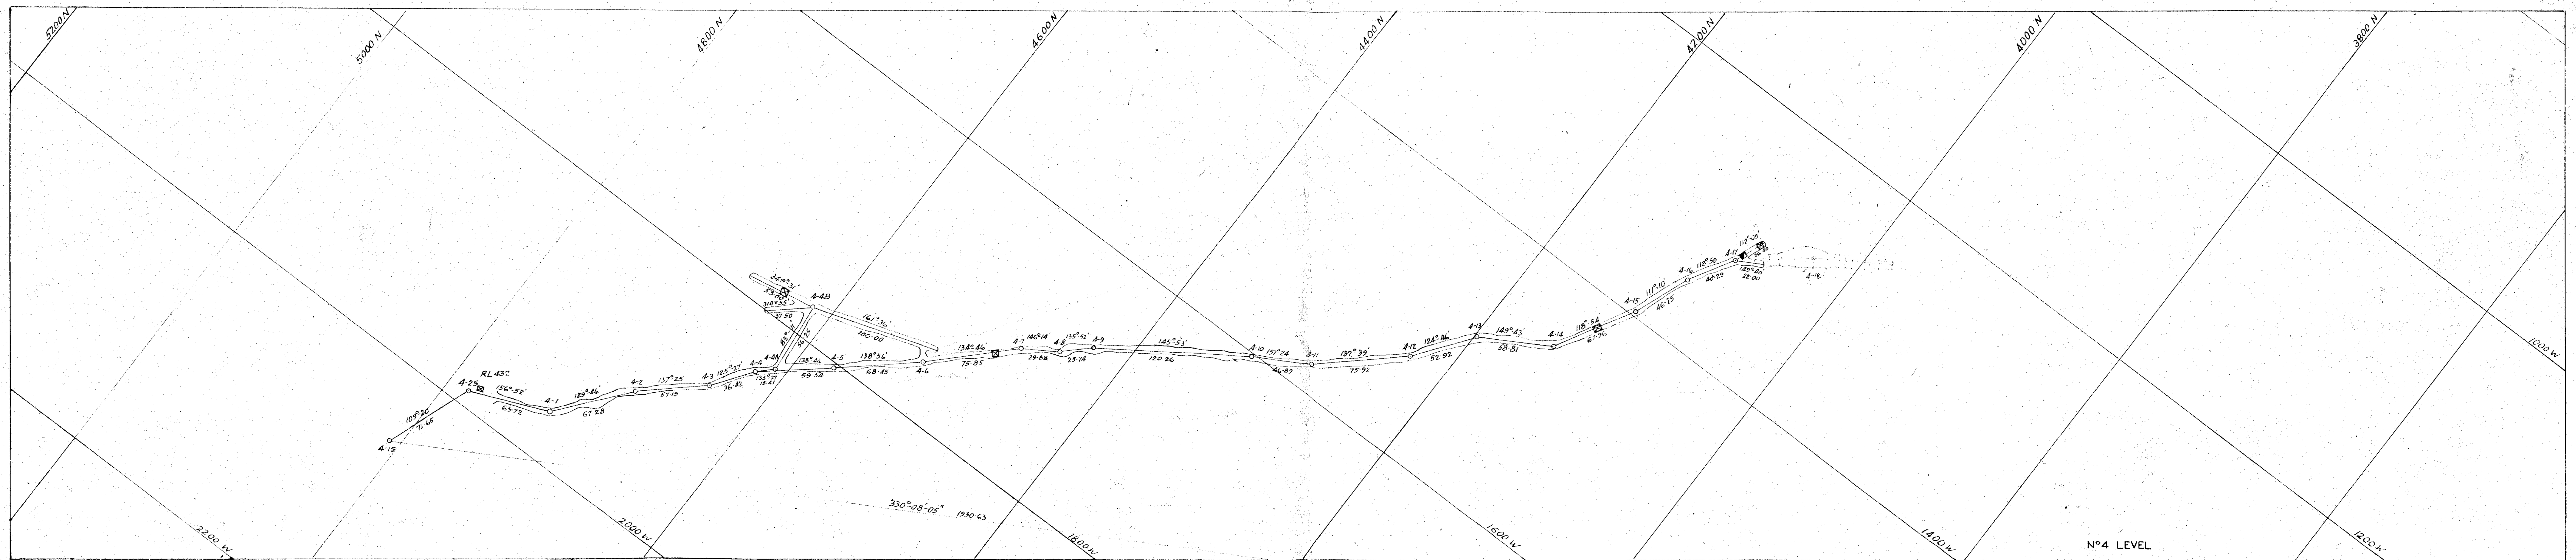


MOUNT BISCHOFF TIN MINE
NORTH VALLEY LODGE
PLAN OF NO 5, 4 & 2 LEVELS

SCALE: 50 FT TO 1 INCH

Alfred SURVEYOR *J. J. Laddy* MANAGER, JUNE 1944

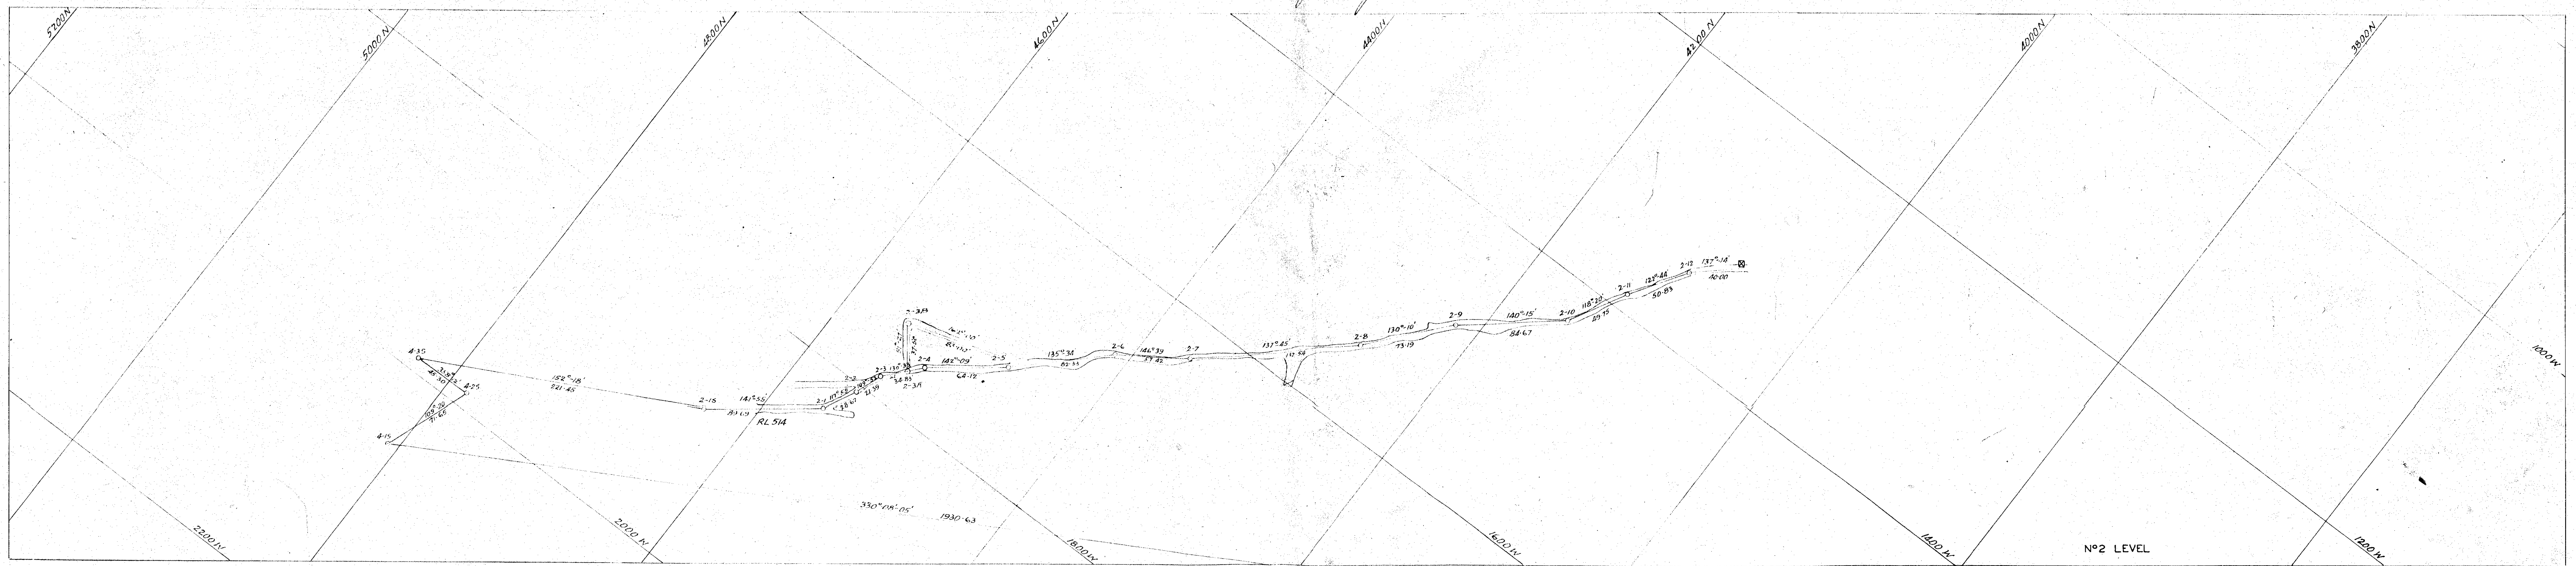

217-228

5 cm

217-228