


MOUNT BISCHOFF TIN MINE
NORTH VALLEY LODGE
LONGITUDINAL SECTION

SCALE: 50 FT TO 1 INCH

A. Carter SURVEYOR. *J. T. Eddy* MANAGER. JUNE 1944
JULY 1945

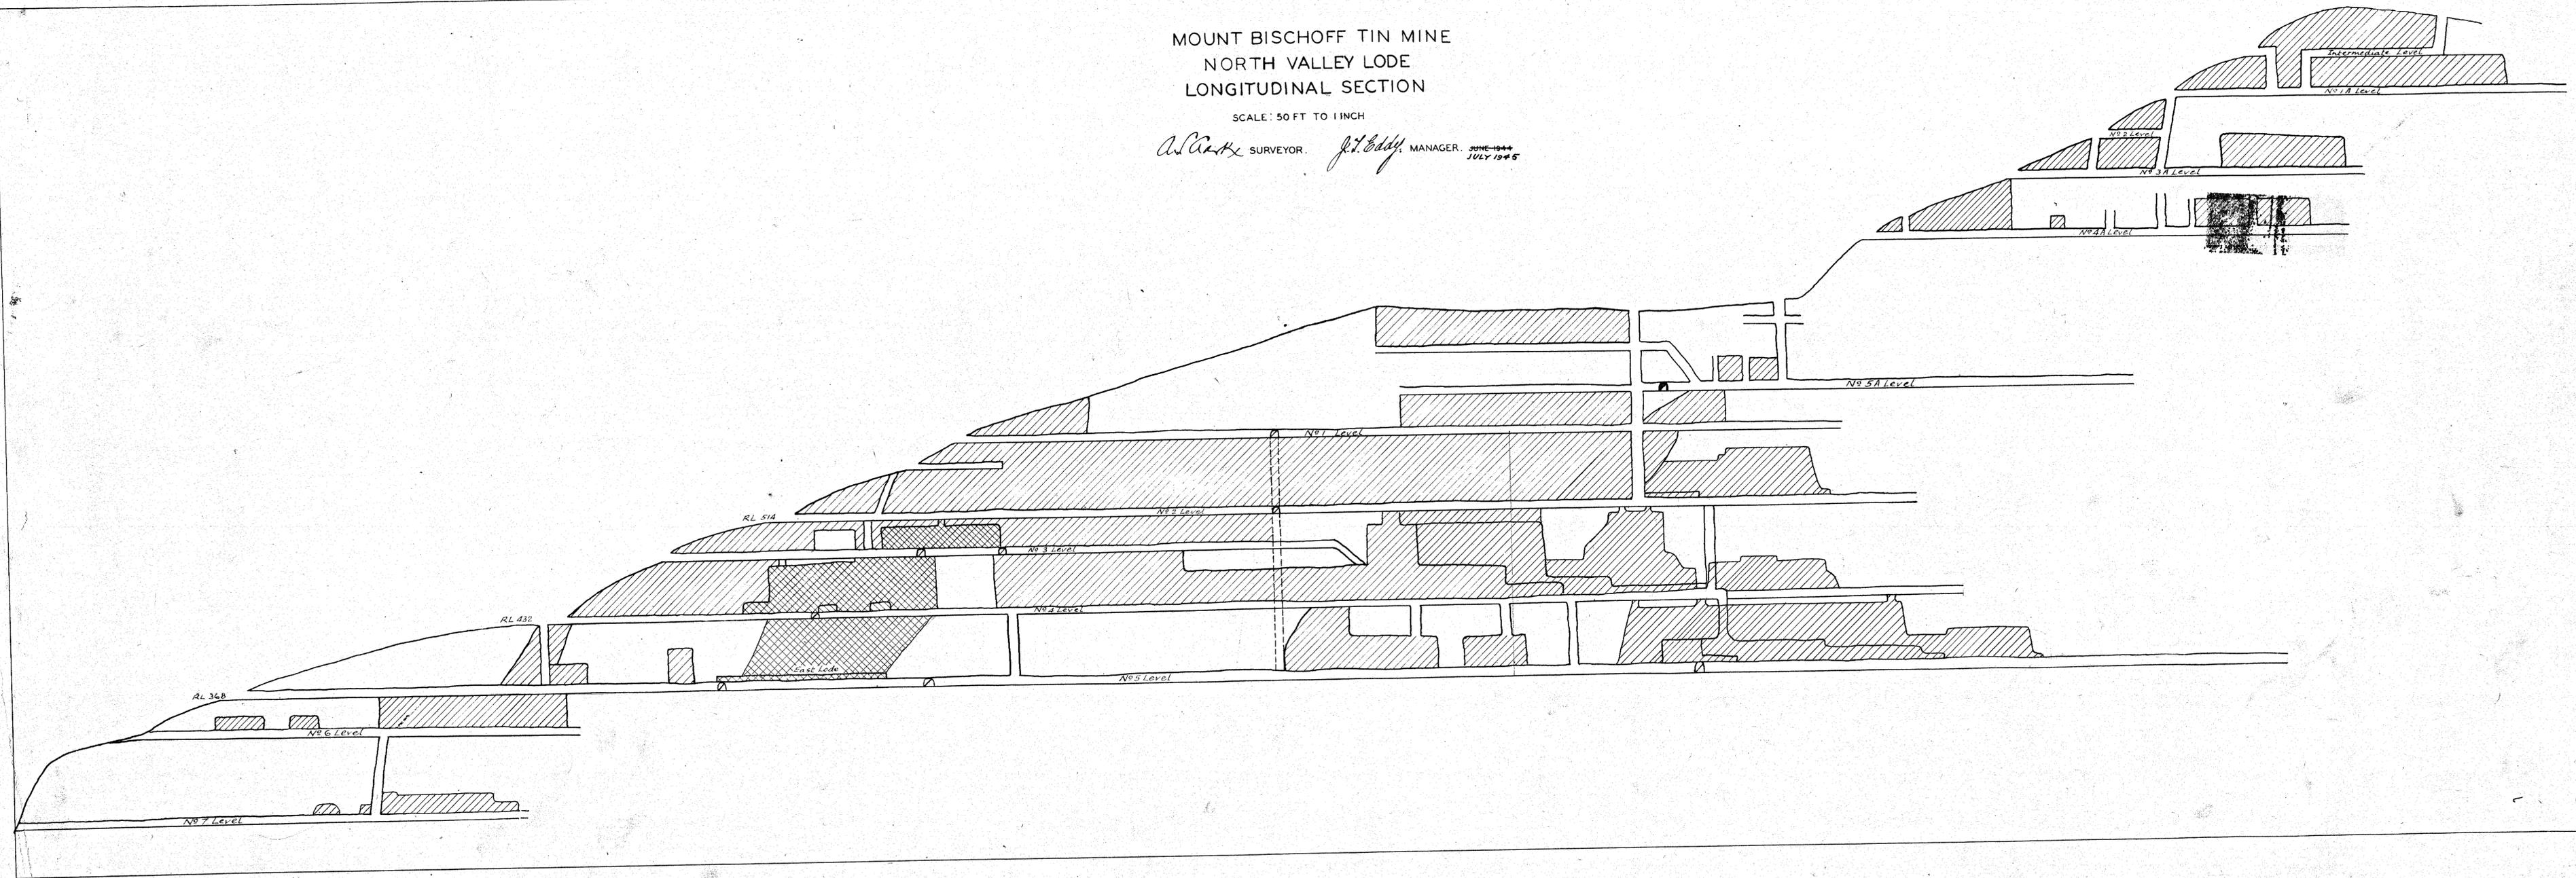

217-229

50m

217-229

J. T. Eddy
12/14/45