



MOUNT BISCHOFF TIN MINE  
NORTH VALLEY LODE  
LONGITUDINAL SECTION

SCALE: 50 FT TO 1 INCH

*A. Carter* SURVEYOR. *J. H. Bddy* MANAGER. JUNE 1944

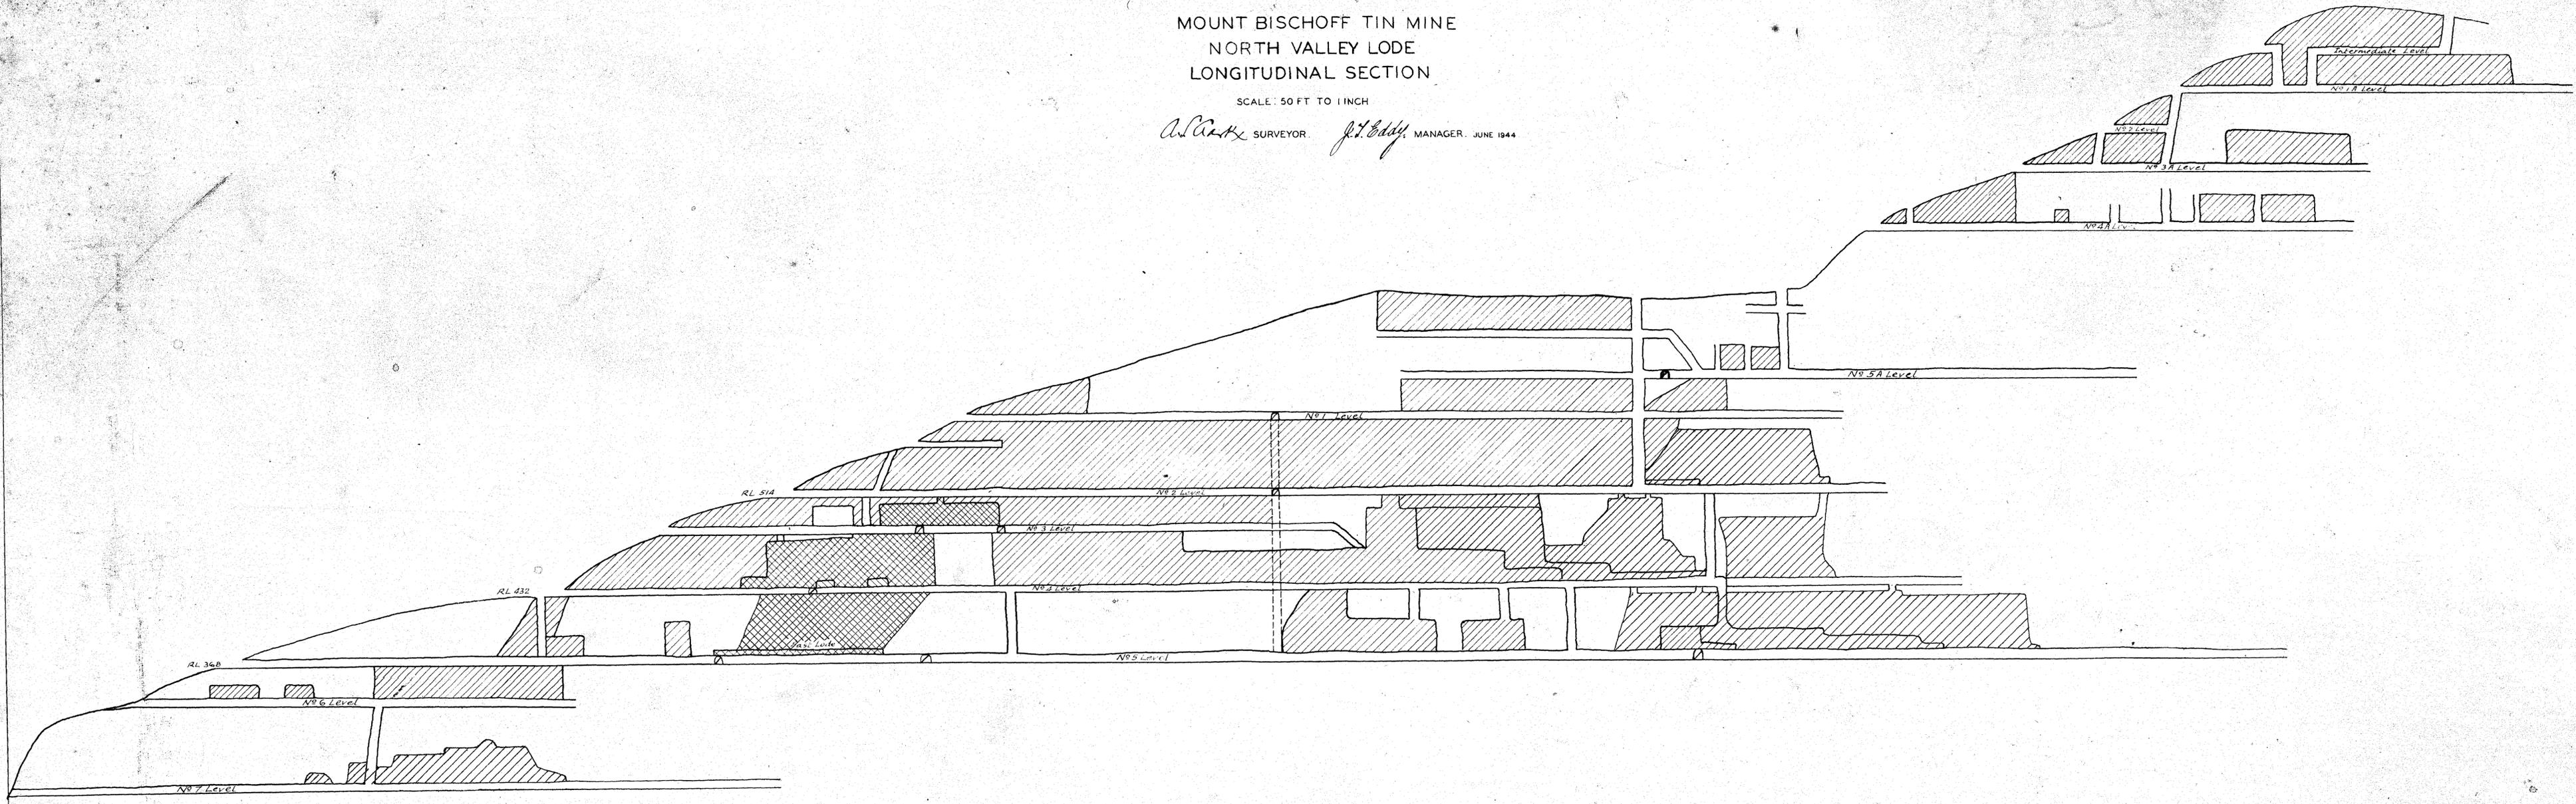

217-230

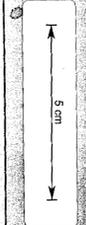

217-230