


 
MOUNT BISCHOFF TIN MINE
NORTH VALLEY LODE
PLAN OF NO. 5, 4 & 2 LEVELS

SCALE: 50 FT TO 1 INCH


W. Hamilton SURVEYOR. *J. T. Gaddy* MANAGER. JUNE 1946
JULY 1945

4" Hand-drawn


217-451

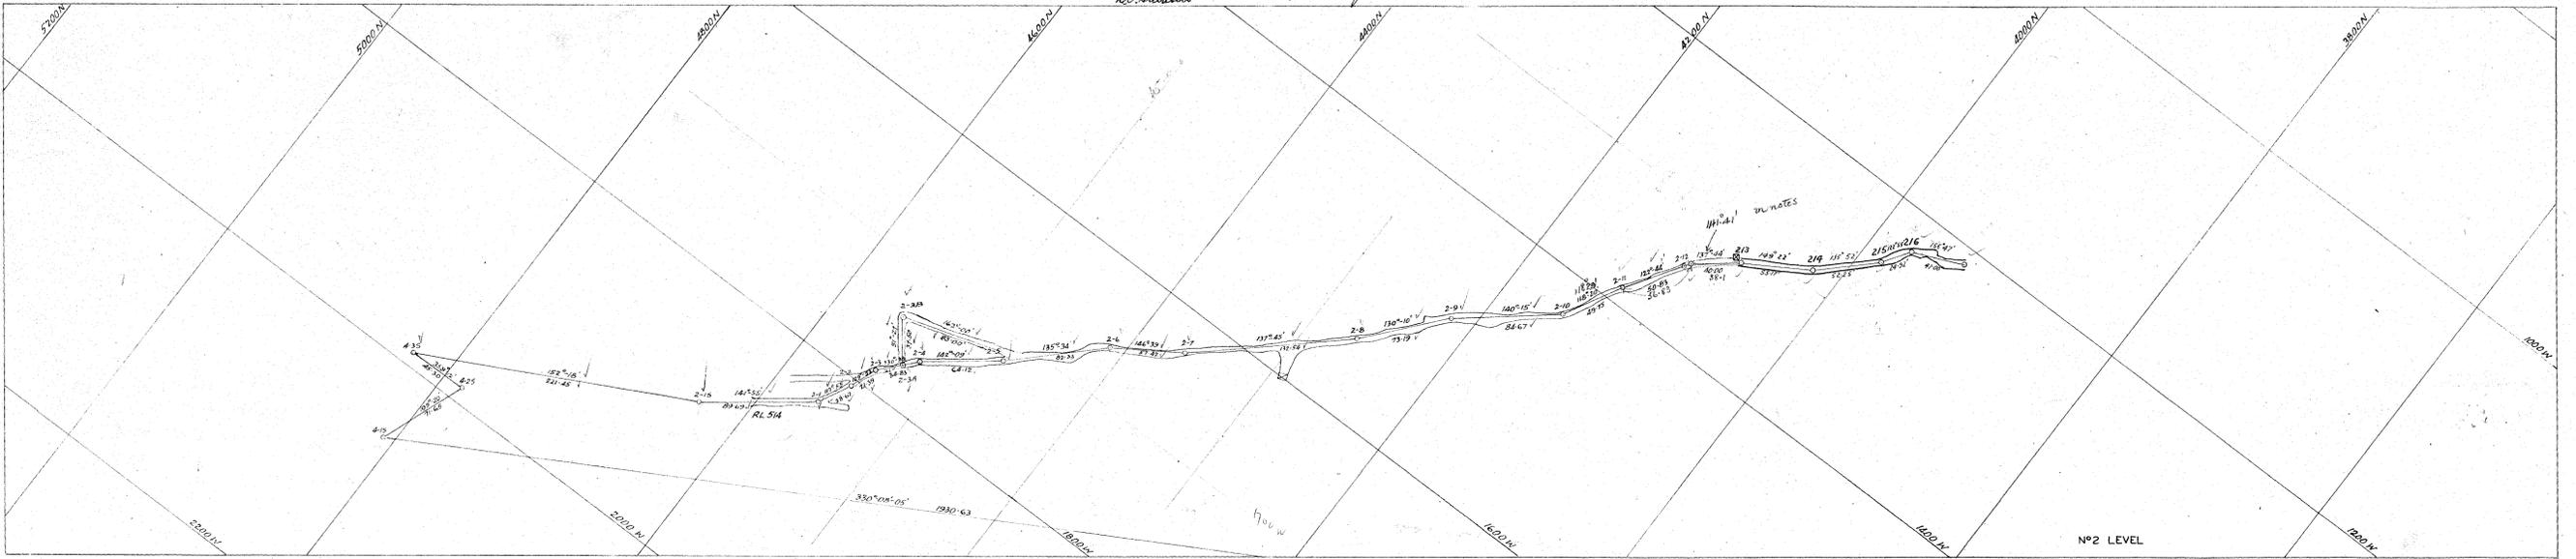

NO. 2 LEVEL

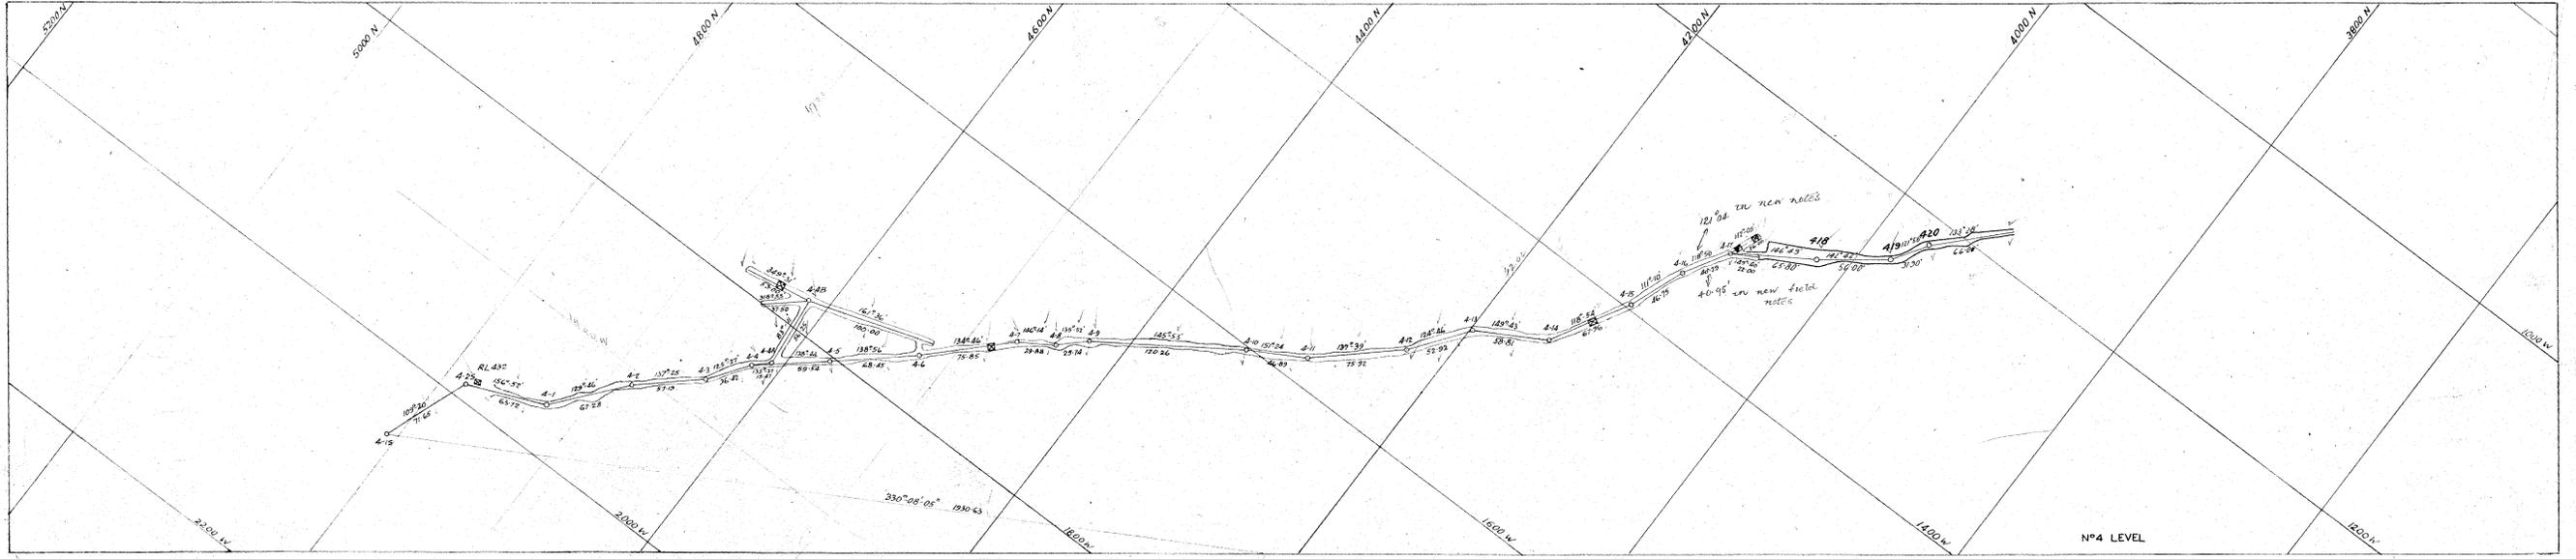

NO. 4 LEVEL

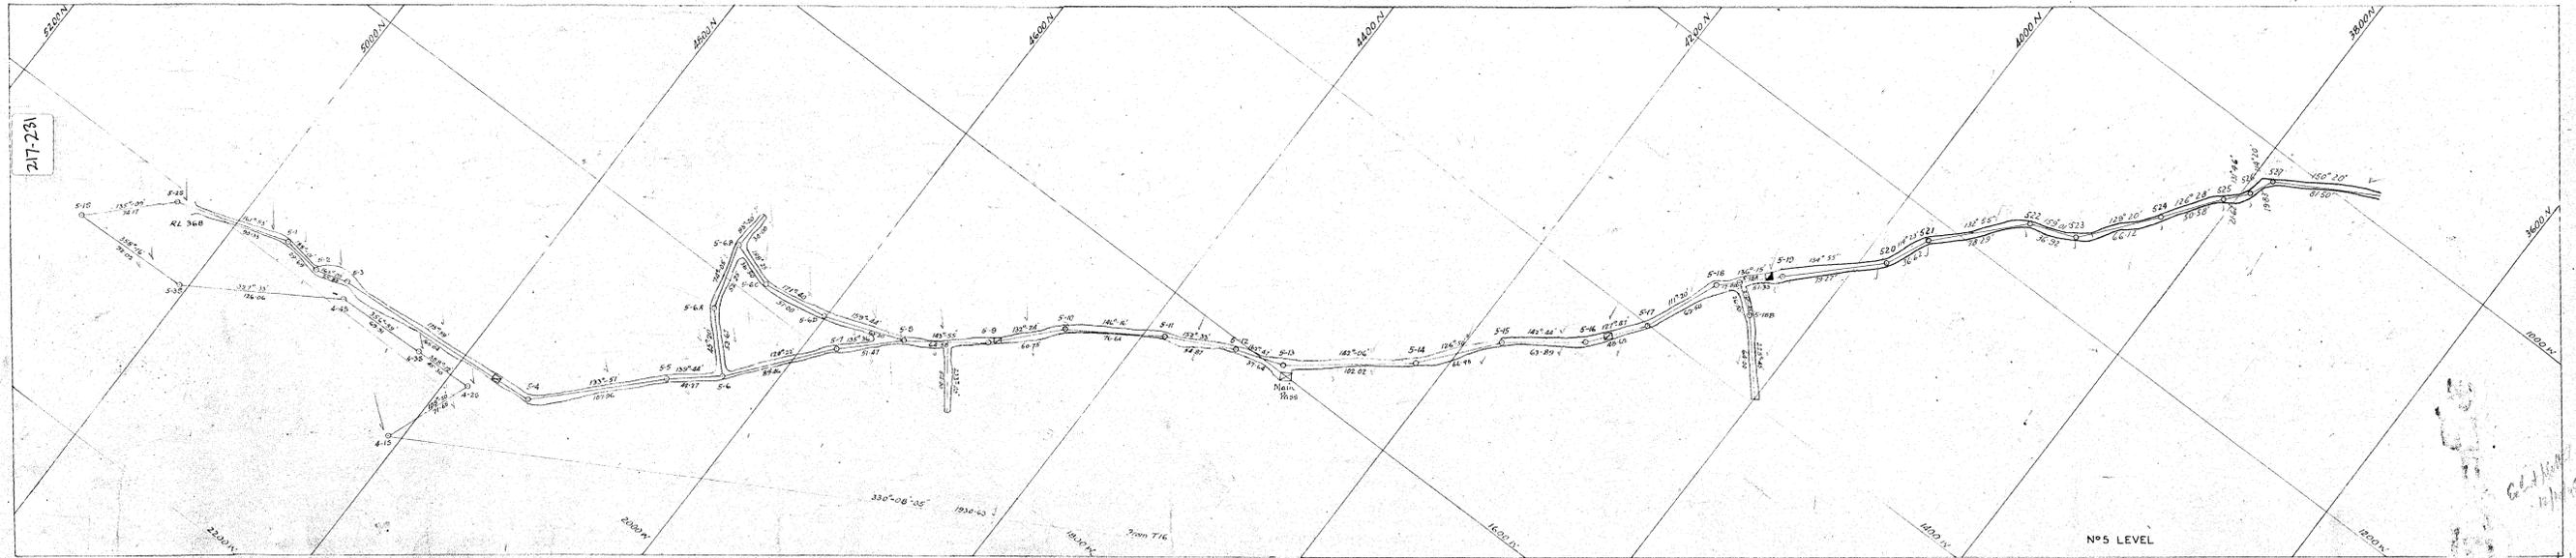

NO. 5 LEVEL

217-231

W. Hamilton
J. T. Gaddy
11-2-45