


217-233

217-233

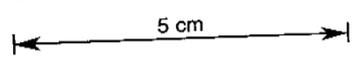

MOUNT BISCHOFF TIN MINE
NORTH VALLEY LODE

No. 7 LEVEL

Scale: 1 in. = 50 ft.

Surveyor, Manager. July 1945

4800 N


5000 N

5200 N

5400 N

2000 W

2200 W

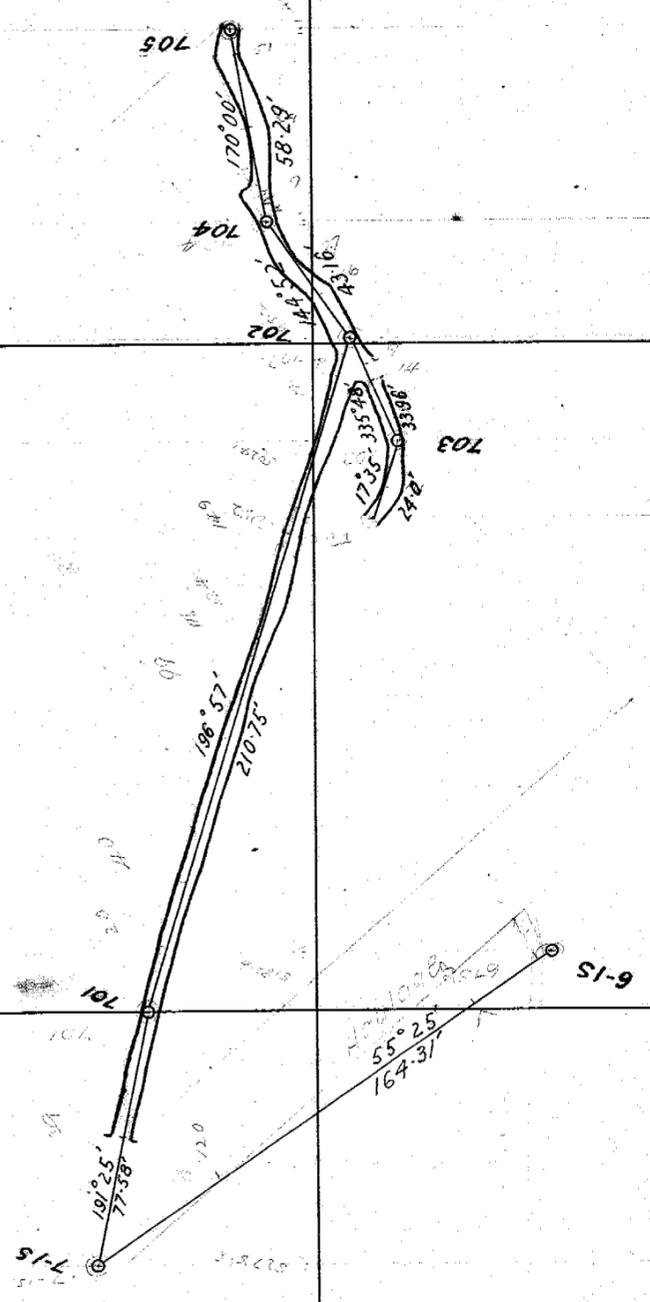

V.V. No 7