
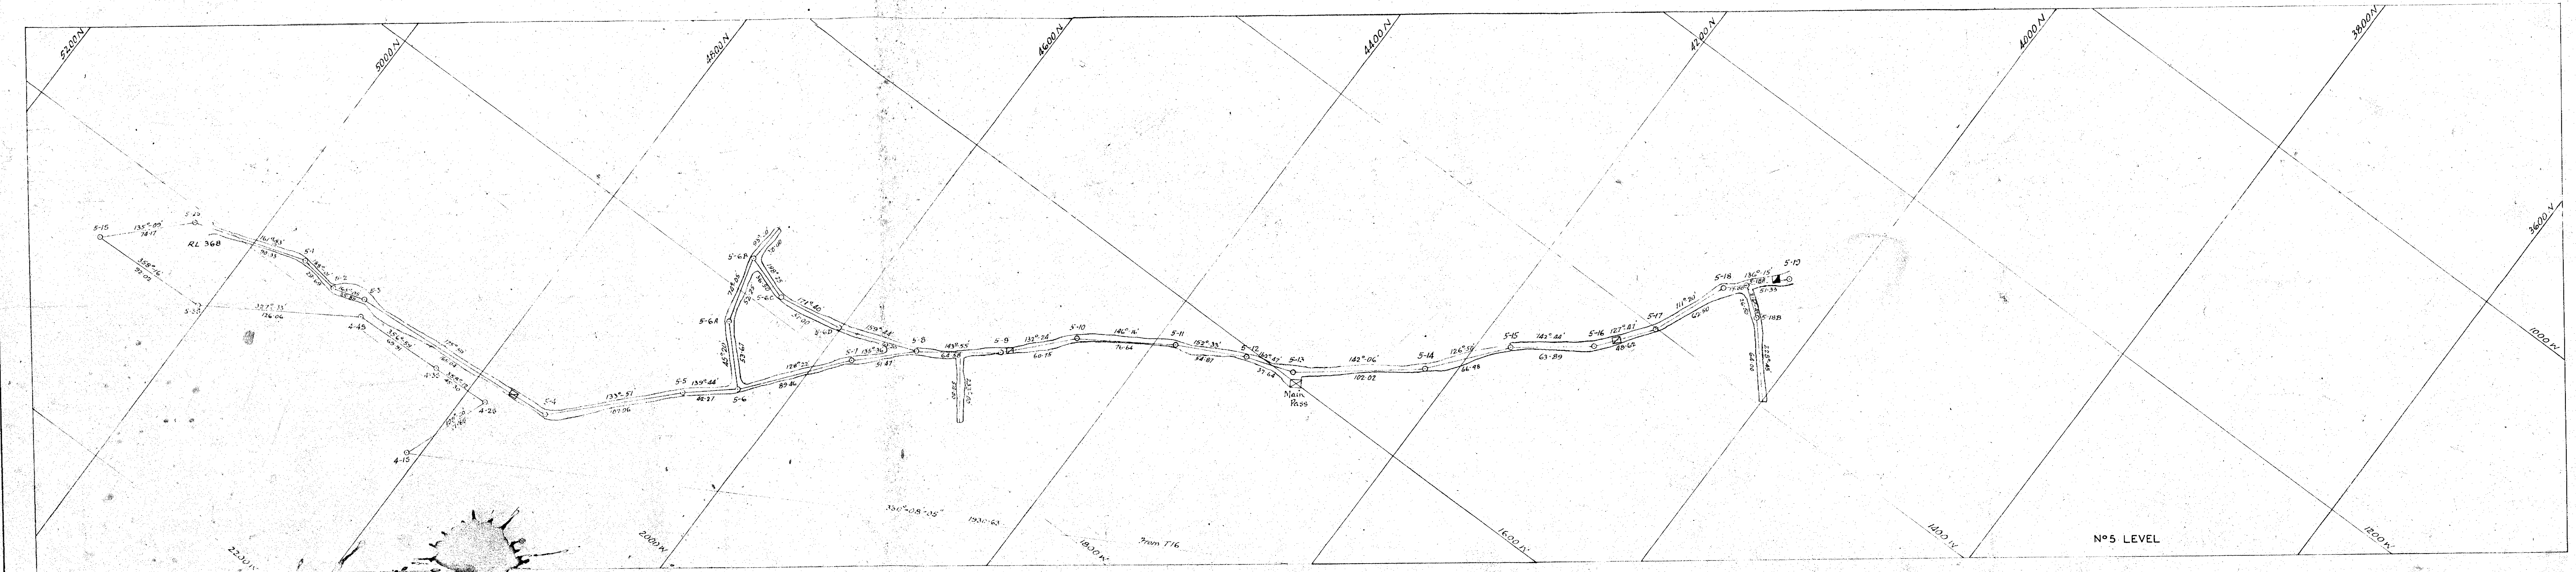
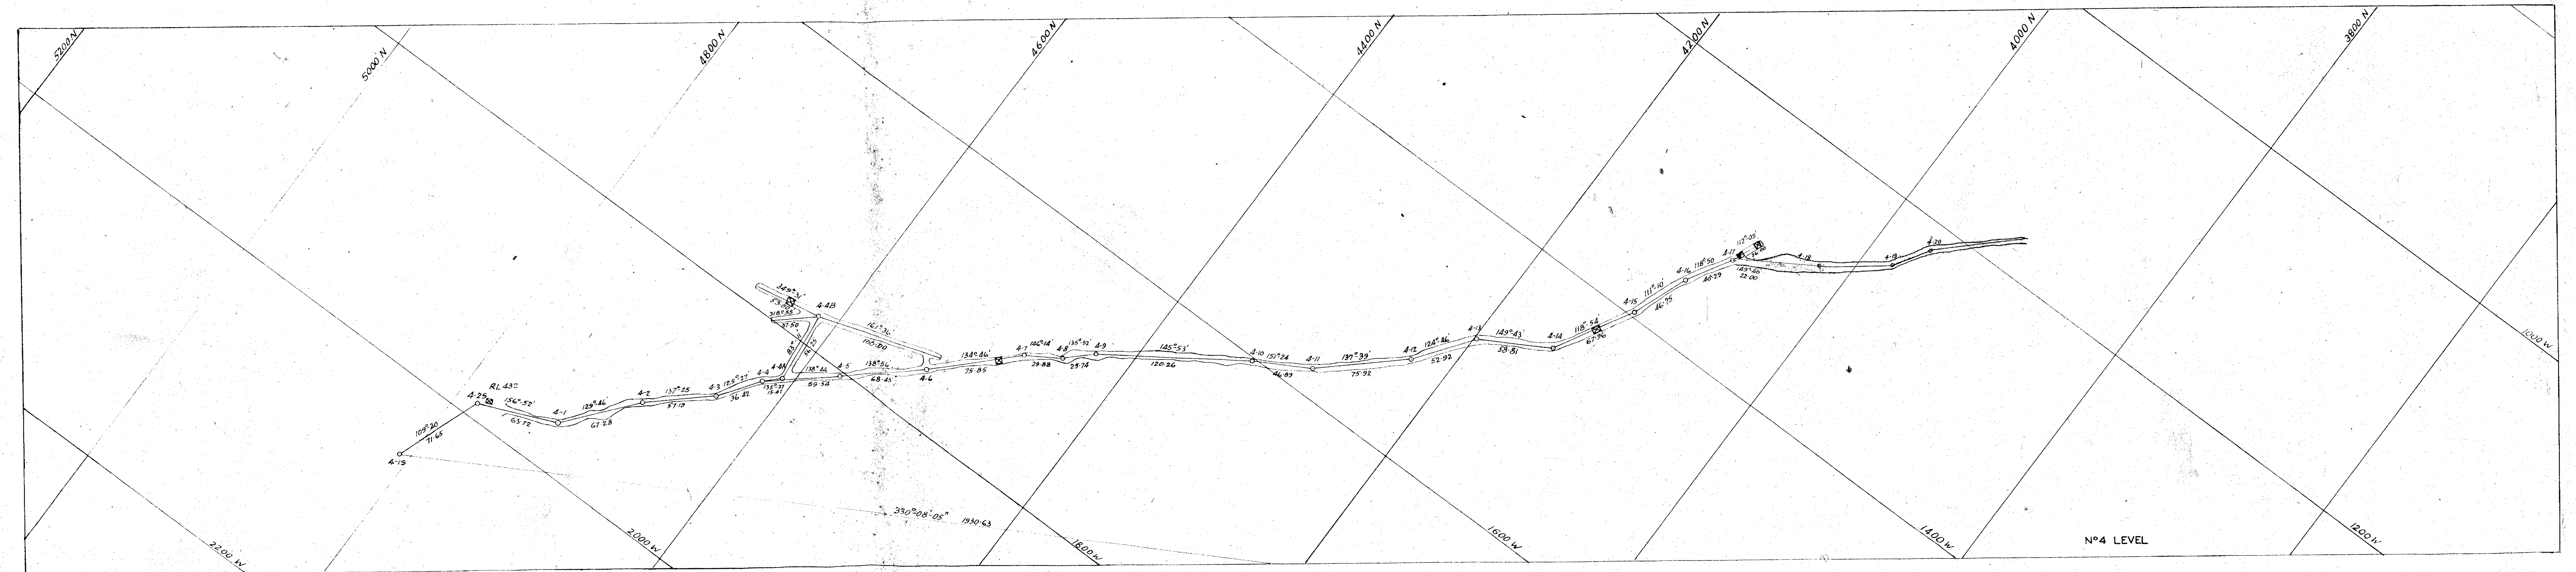


MOUNT BISCHOFF TIN MINE
NORTH VALLEY LODGE
PLAN OF N° 5, 4 & 2 LEVELS

SCALE: 50 FT TO 1 INCH

W. C. ... SURVEYOR. *J. T. ...* MANAGER. JUNE 1944

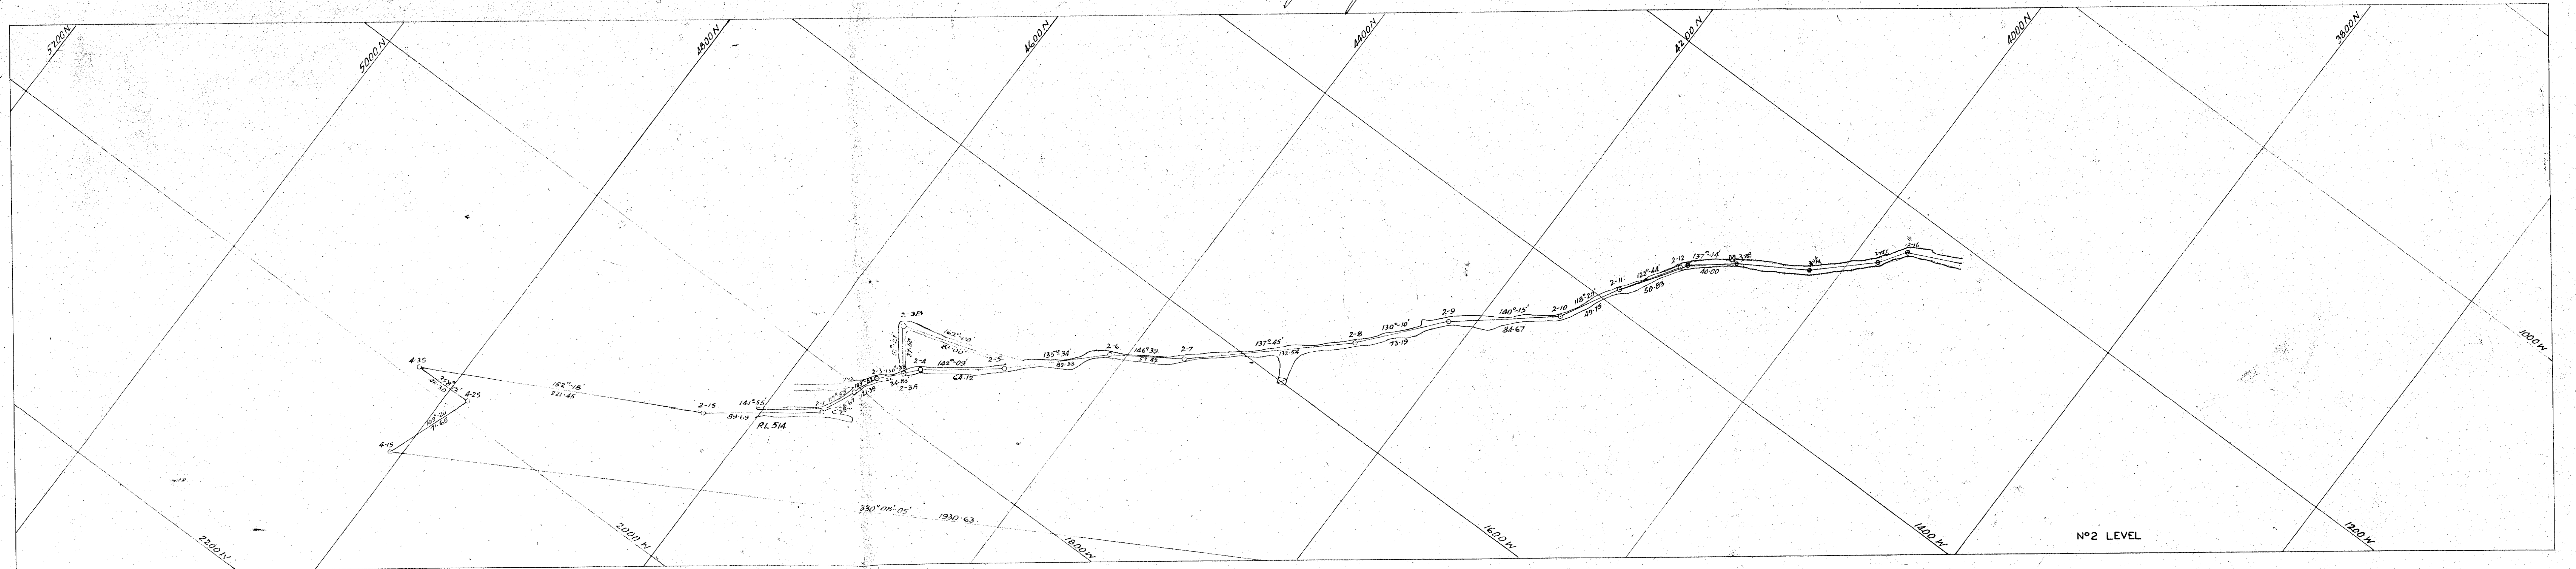

217234

50m

217234