


MOUNT BISCHOFF TIN MINE  
NORTH VALLEY LODE  
LONGITUDINAL SECTION

SCALE: 50 FT TO 1 INCH

*A. Carter* SURVEYOR     *J. T. Eddy* MANAGER, JUNE 1944

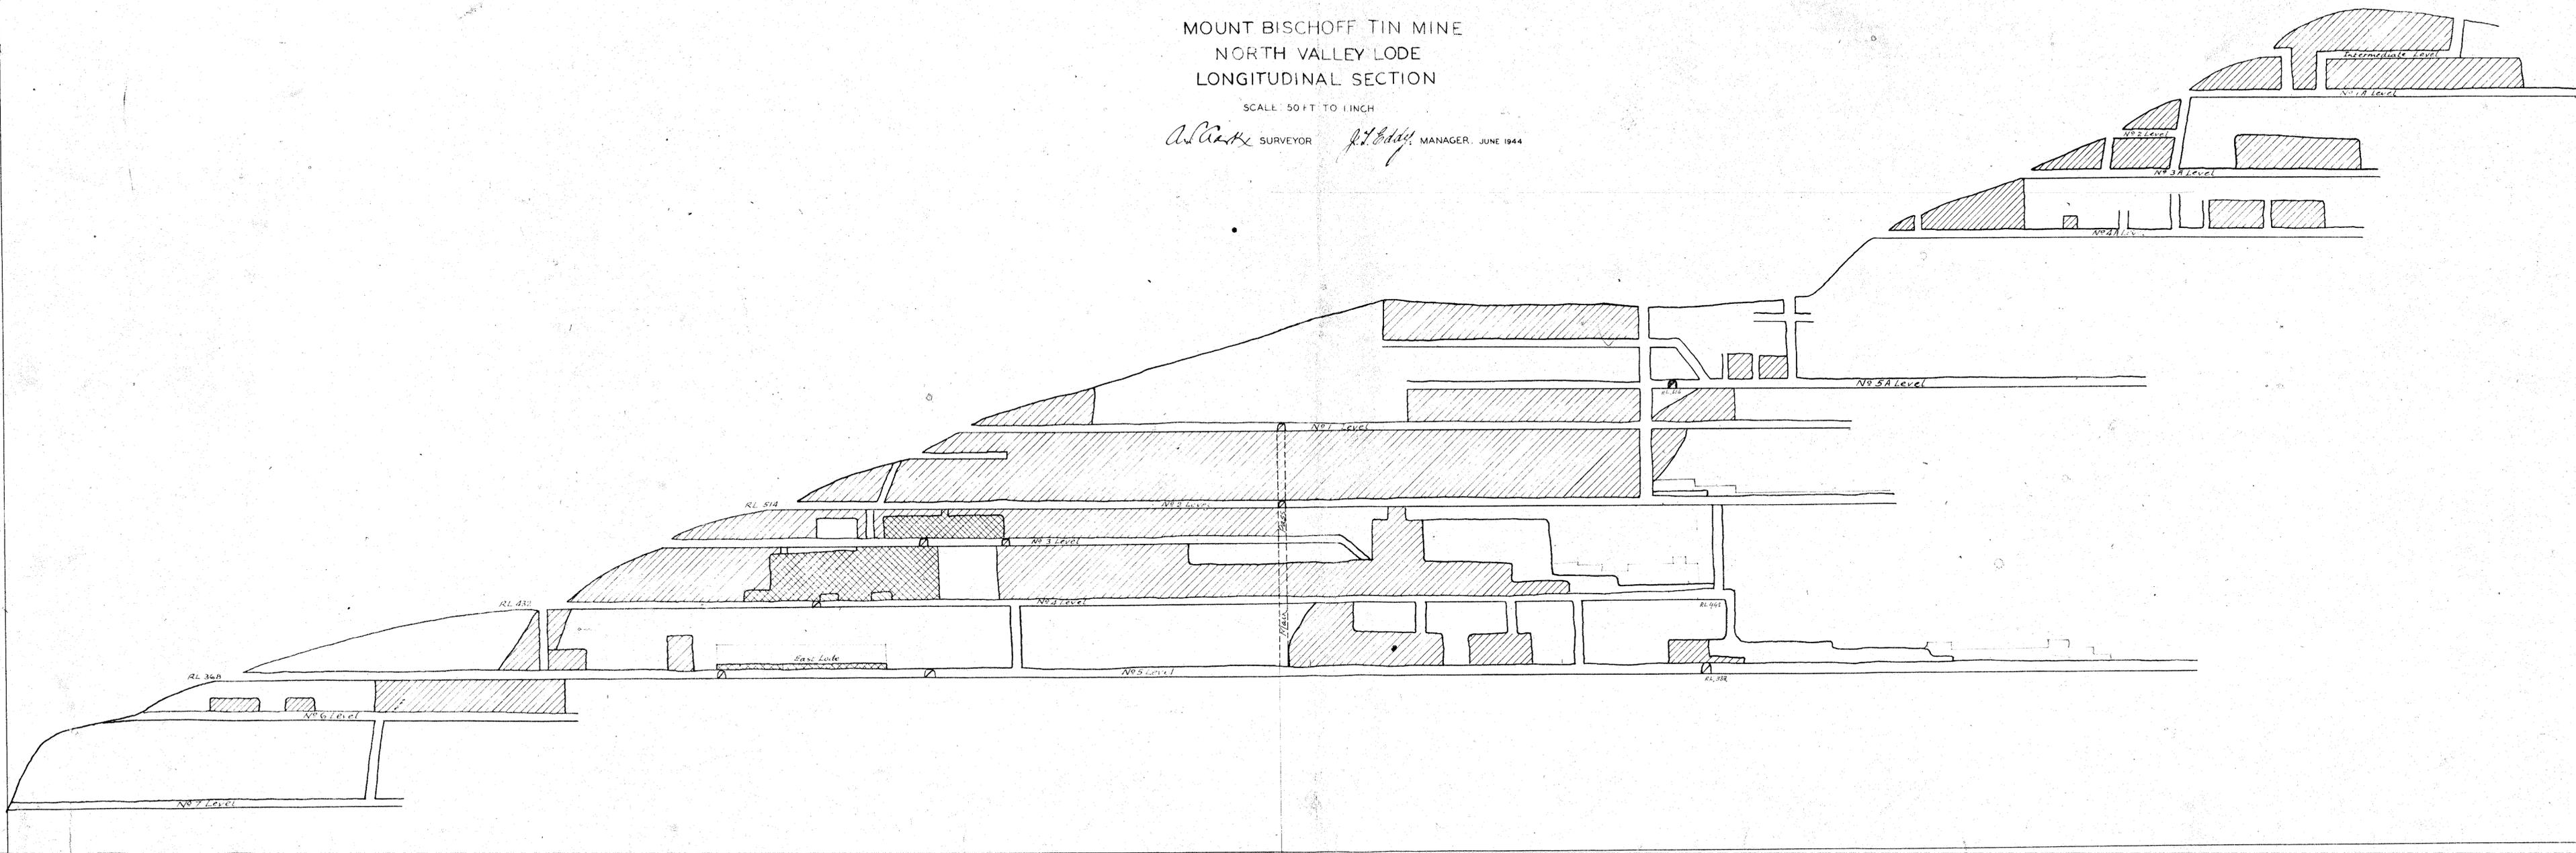

217-236

50 FT  
1

217-236