
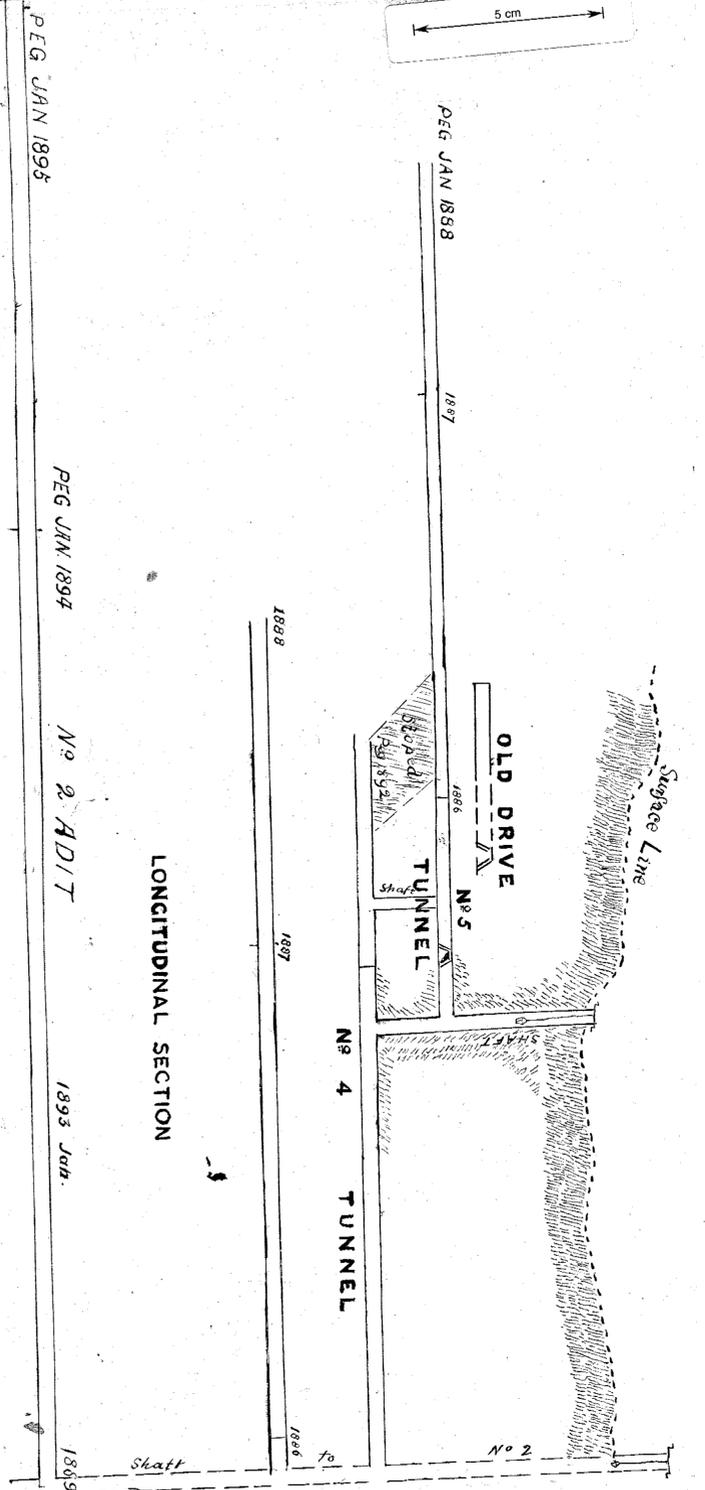


# THE MOUNT BISCHOFF T. M. COMPANY'S UNDERGROUND WORKS NORTH VALLEY

Scale 50 Feet to one Inch

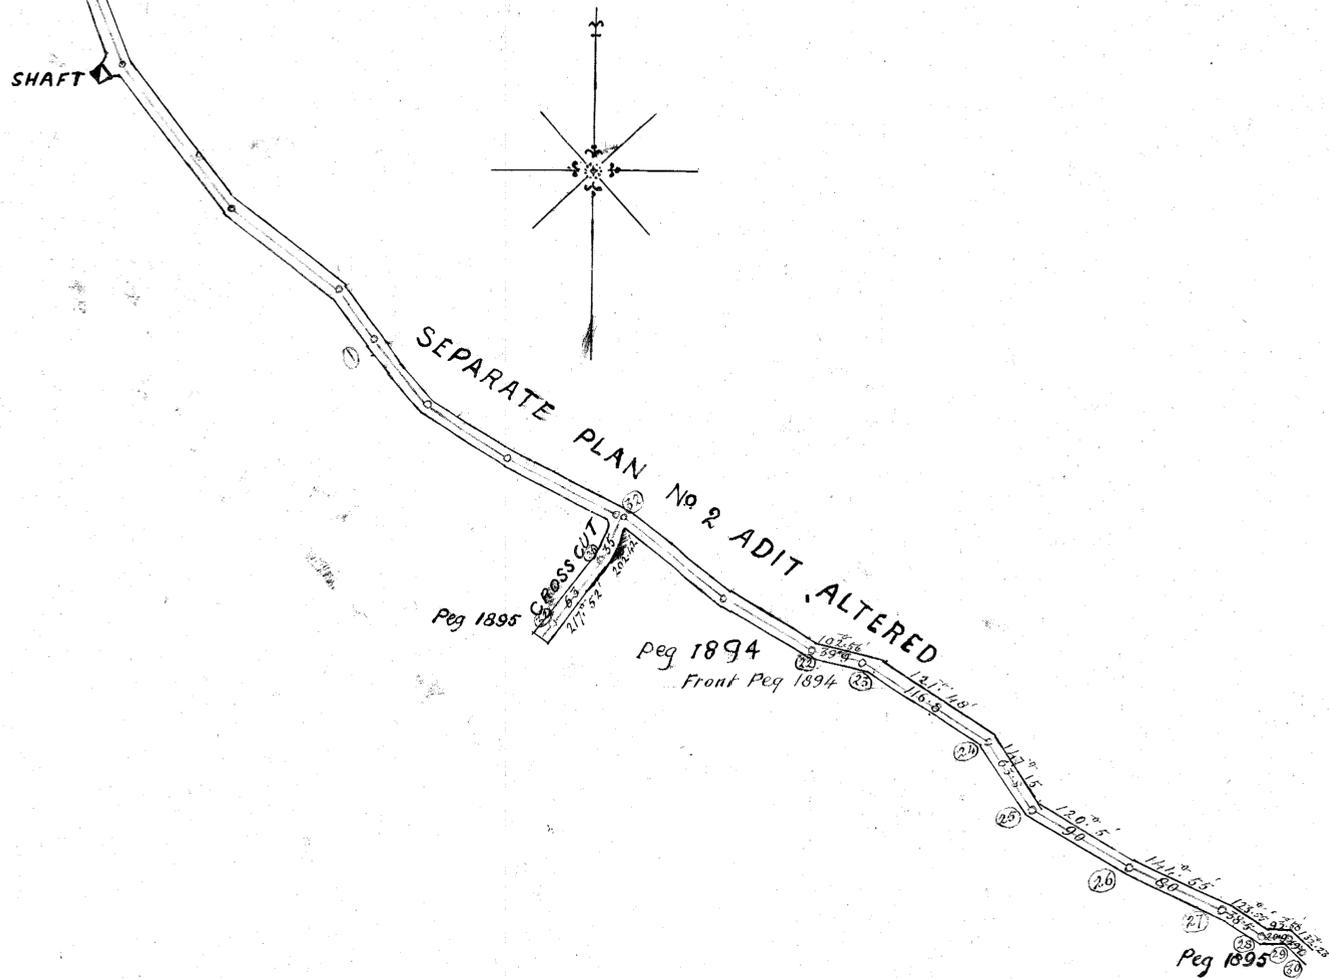

WARATAH 1895  
*Xavier Jones*  
 District Surveyor.  
 January 1895

122

122

UNIVERSITY OF TORONTO