



THE MOUNT BISCHOFF T. M. COMPANY'S  
**UNDERGROUND WORKS**  
**NORTH VALLEY**

Scale 50 Feet to one Inch

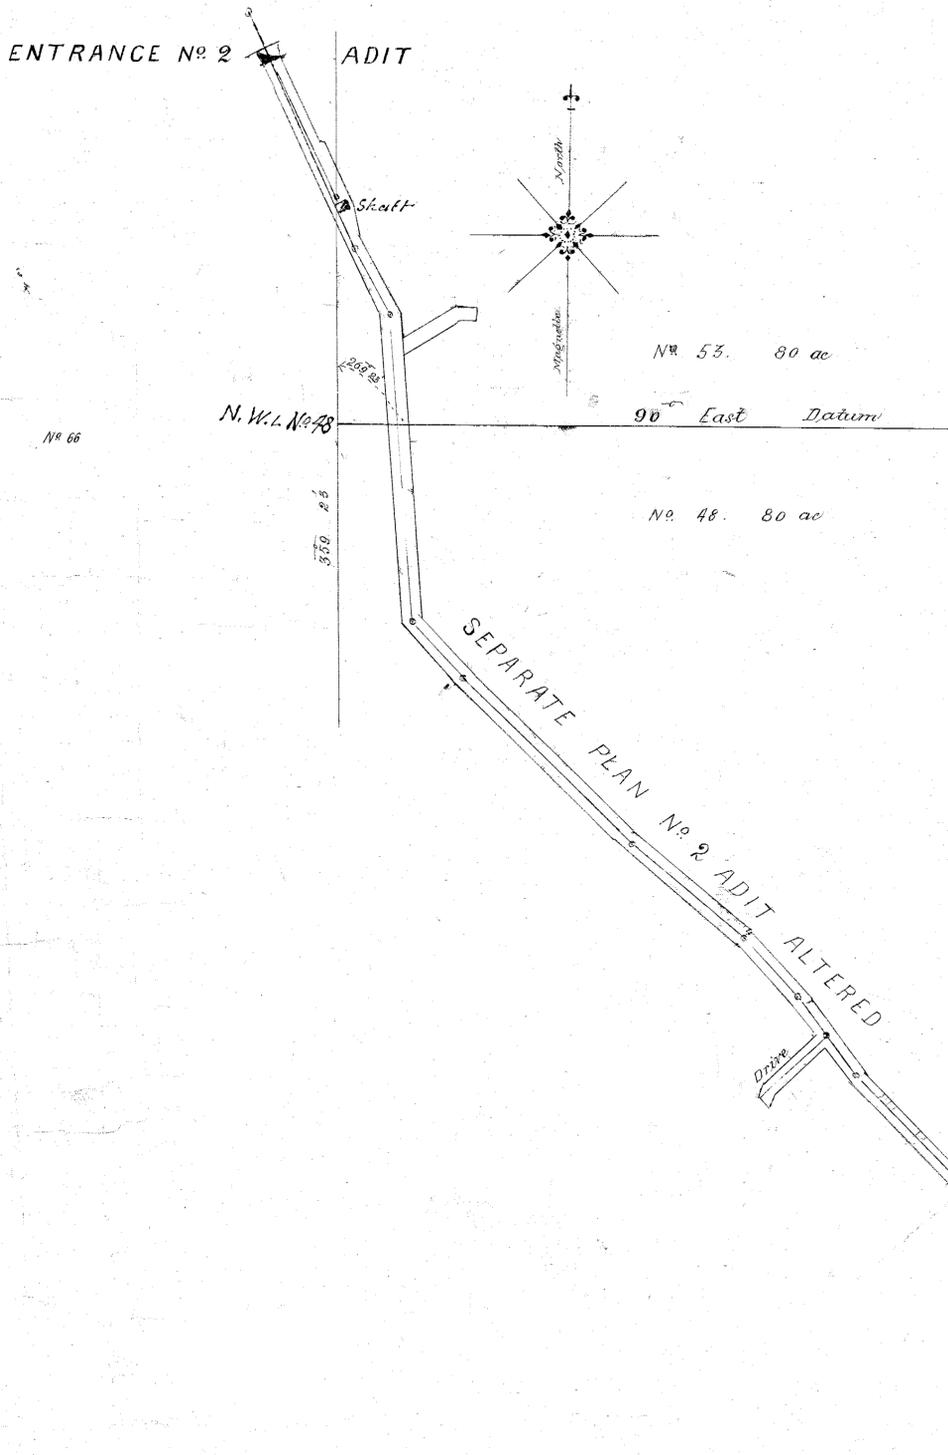

217-240

217-240

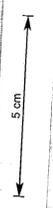

PEG JAN. 1893

*Lamin Jones,  
 District Surveyor,  
 Warrenton,  
 February 10<sup>th</sup> 1893.*

*Mt Bischoff T. M. Co. 1893*