


217-241

25011012

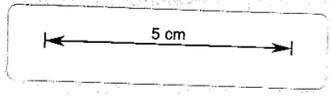


217-241

THE MOUNT BISCHOFF COMPANY'S UNDERGROUND WORKS

NORTH VALLEY

Scale 50 Feet to one Inch

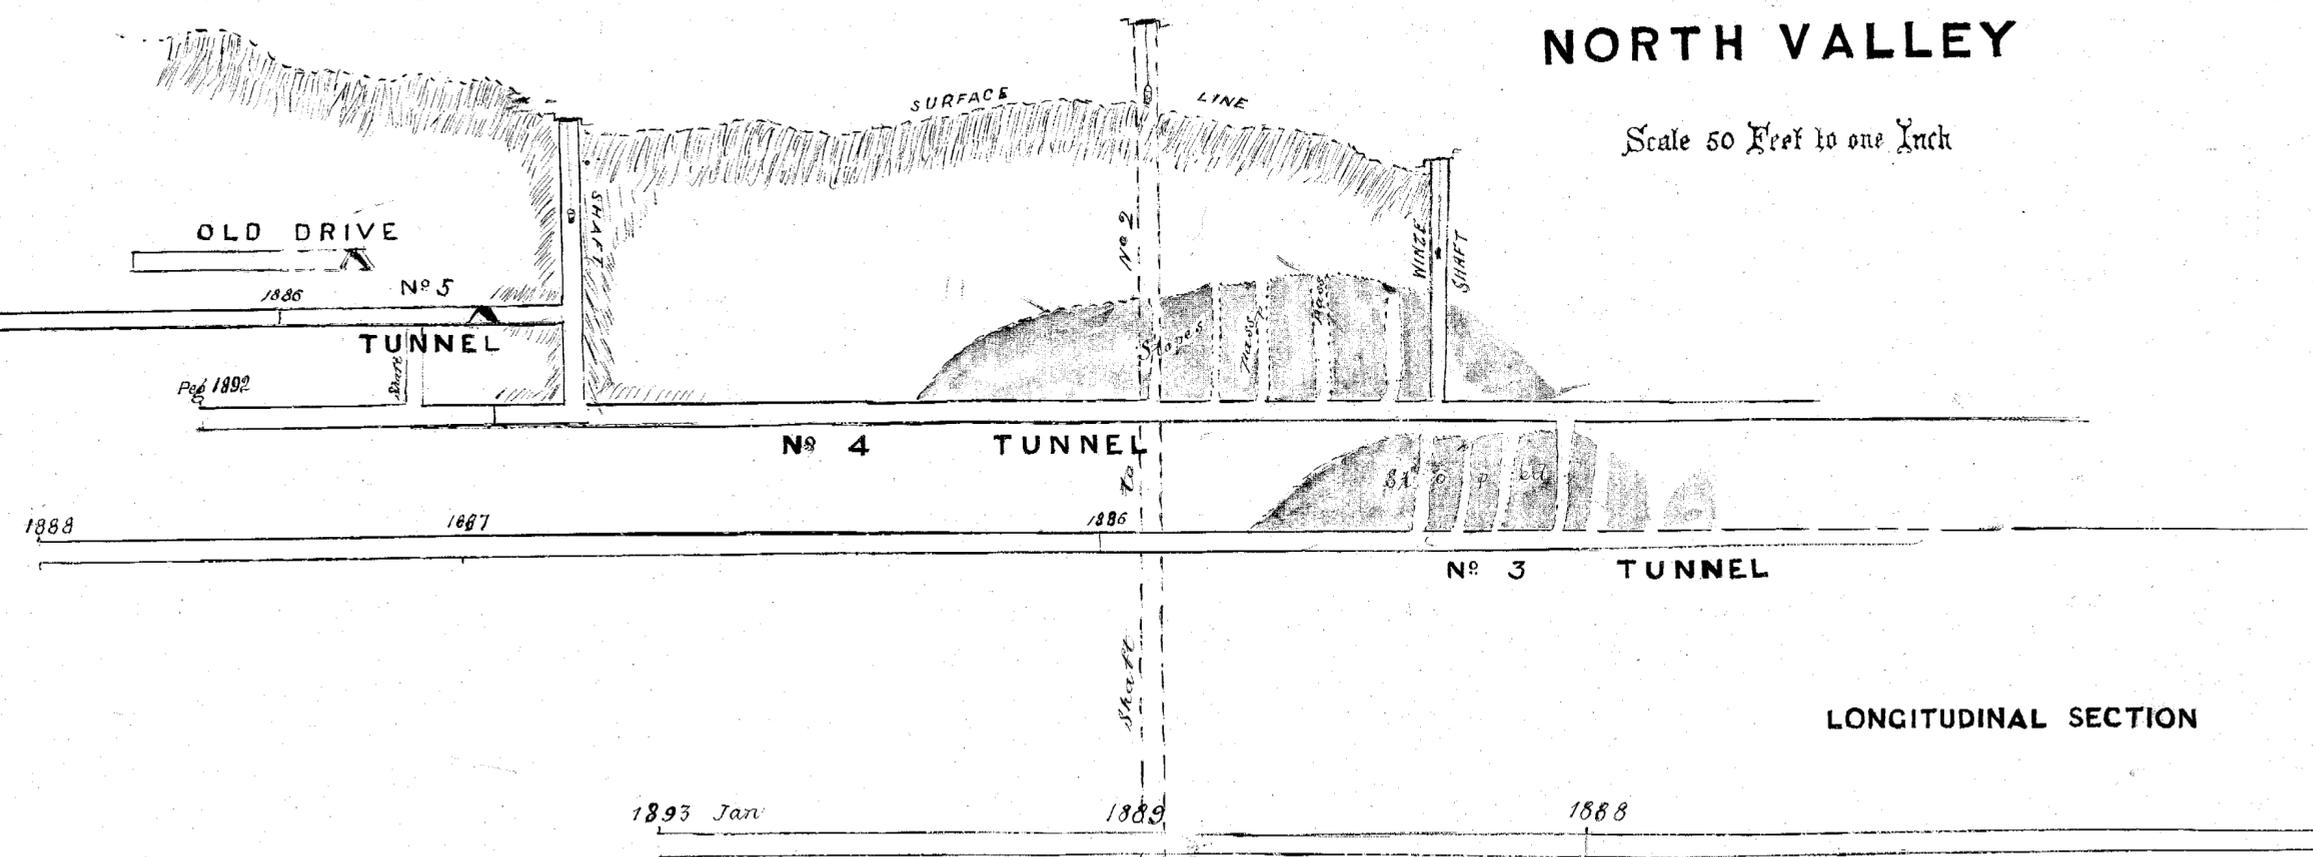

LONGITUDINAL SECTION

L. M. Jones, District Surveyor,
WARATAH 1893.