

217-242


2/2/94



Mount Bischoff T. M. Co.

North Valley

Scale 50 Feet to an Inch

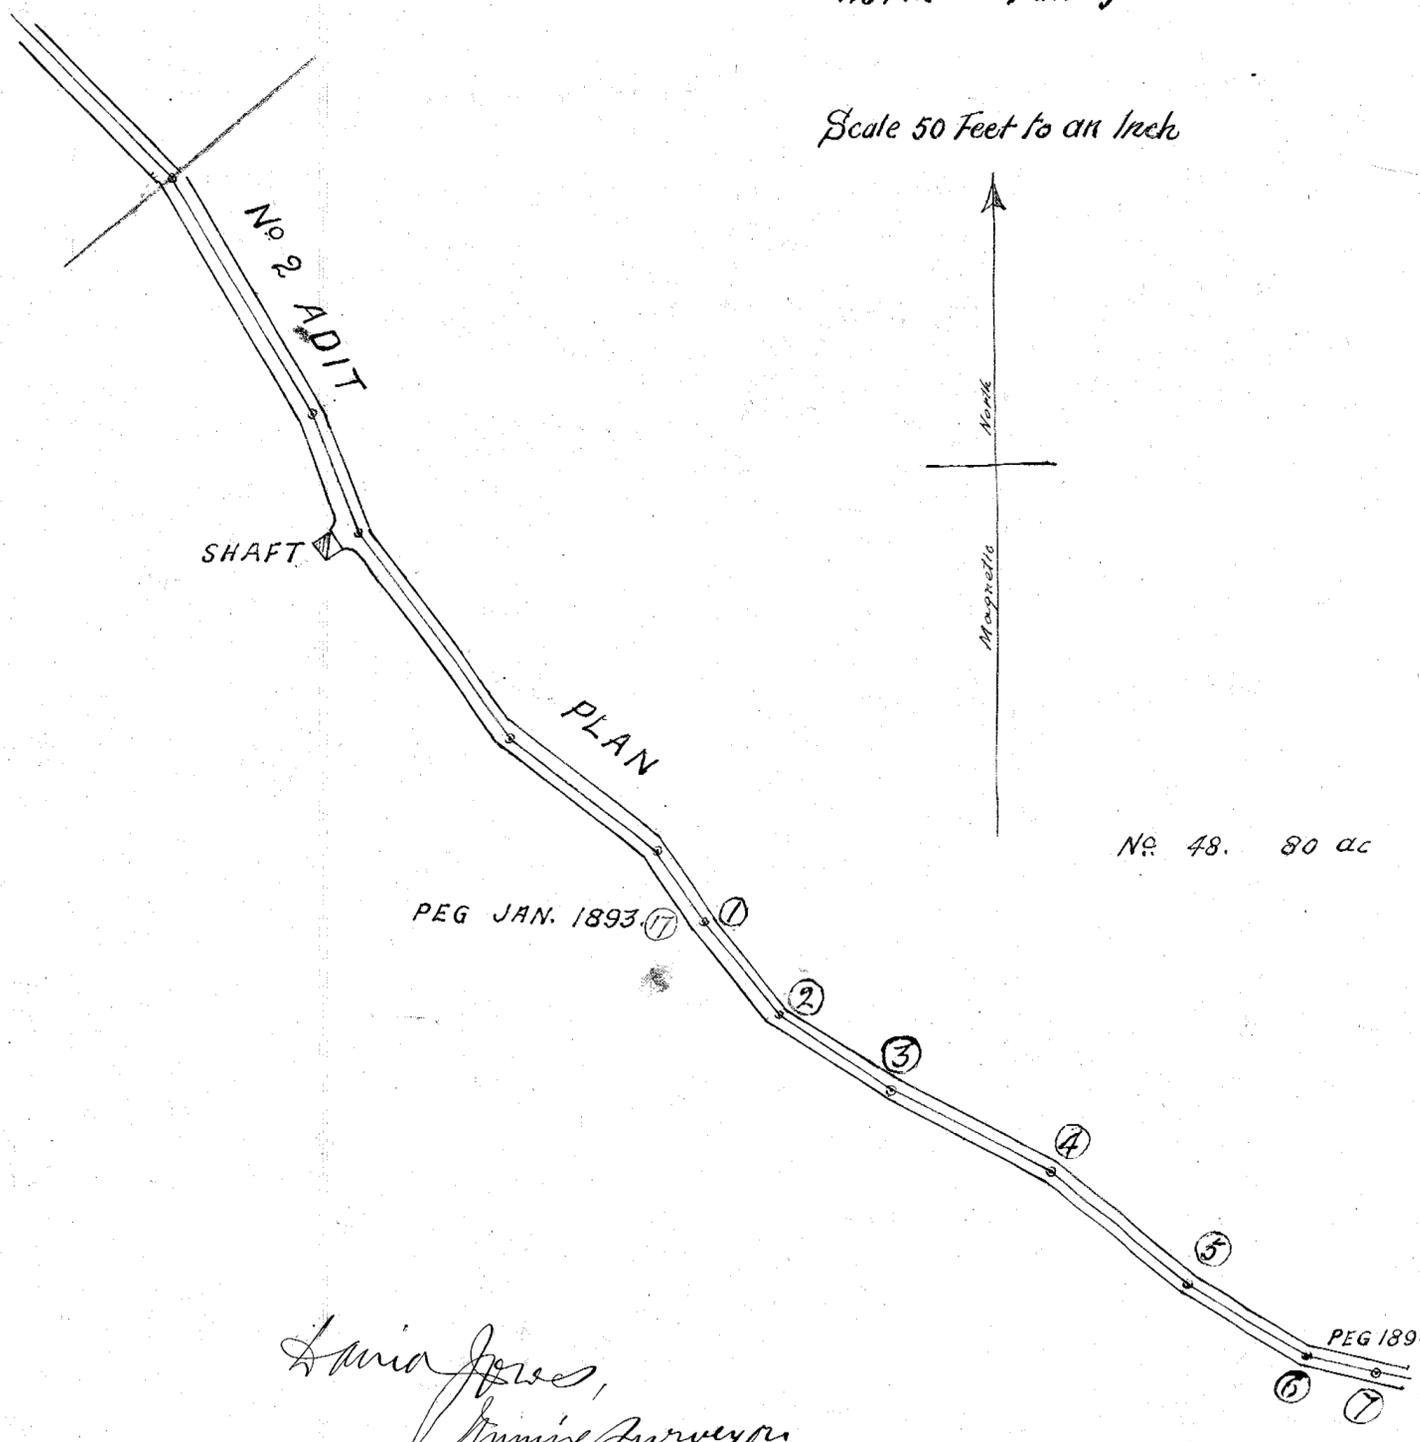

PEG JAN. 1893. ①

No. 48. 80 ac

PEG 1894. JAN. No 2 ADIT.

Louis Jones,
Mining Surveyor
Barataria.
January 29th 1894