


217-243

5 cm

217-243

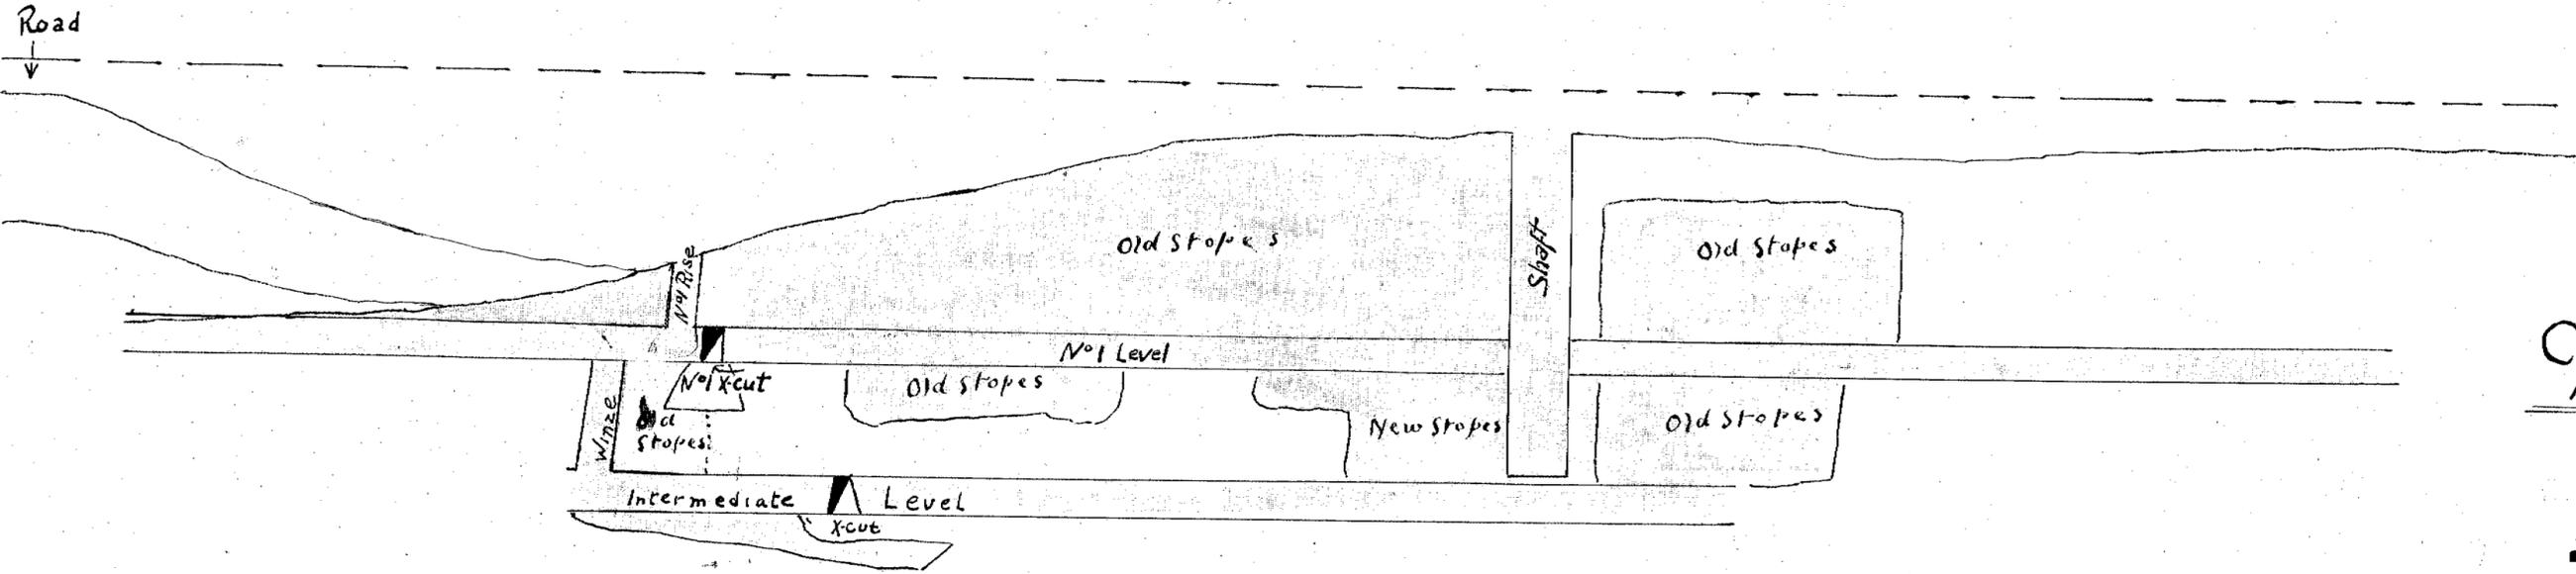

956<sup>th</sup> Bischoff L. 956. Co Reg.

# — THOMPSON LODE —

— LONGITUDINAL SECTION —

— SCALE 25 FT TO 1 INCH —

Work 1933  
 Surveyor W. H. Porter  
 Instrument used 5" theodolite