


MT BISCHOFF T. M. CO REG.

THOMPSON LODE

TRANSVERSE SECTION

SCALE 25 FT TO 1 INCH

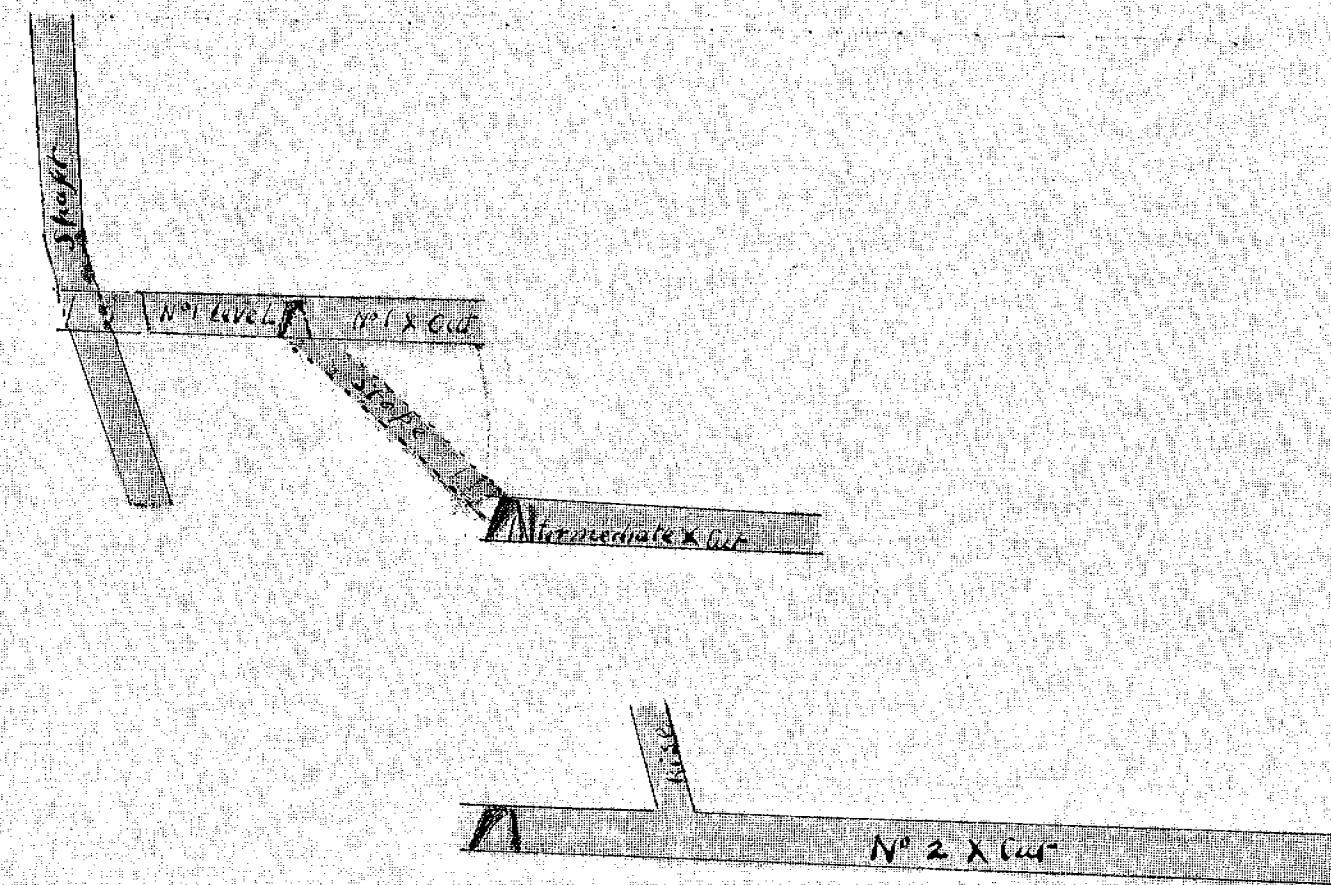

Surveyor W. Port
Instrument 4" theodolite
11/3/32

217-244

5 cm

217-244