


Rosa

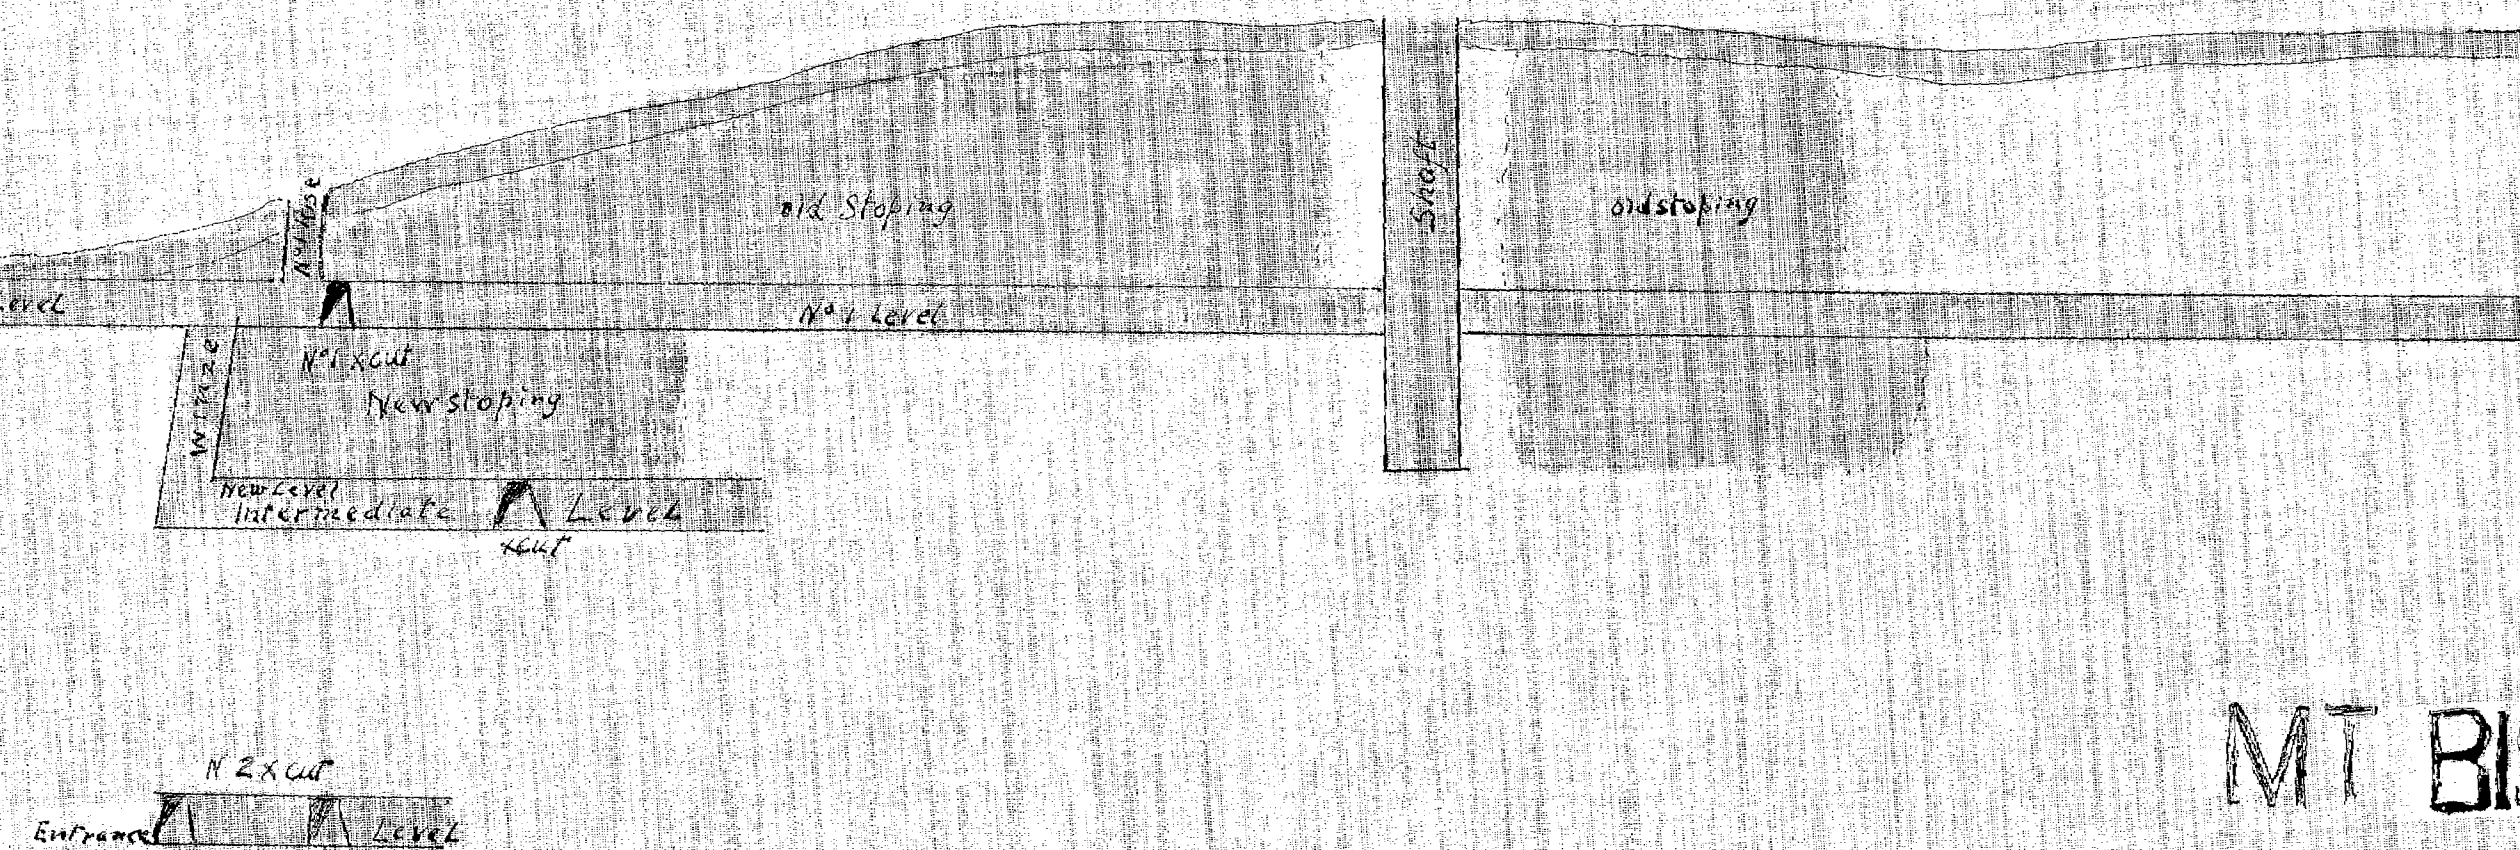

MT BISCHOFF T M CO REG
THOMPSON LOOC

LONGITUDINAL SECTION

SCALE 25 FT = 1 INCH

Surveyor W. Porter
Just used 4" theodolite
11/3/32

21-12

21-215