

— MT BISCHOFF T. M. CO. REG —

— THOMPSON LODE —


— TRANSVERSE SECTION —

— SCALE 25 FT TO 1 INCH —

217-216

5 cm

217-216

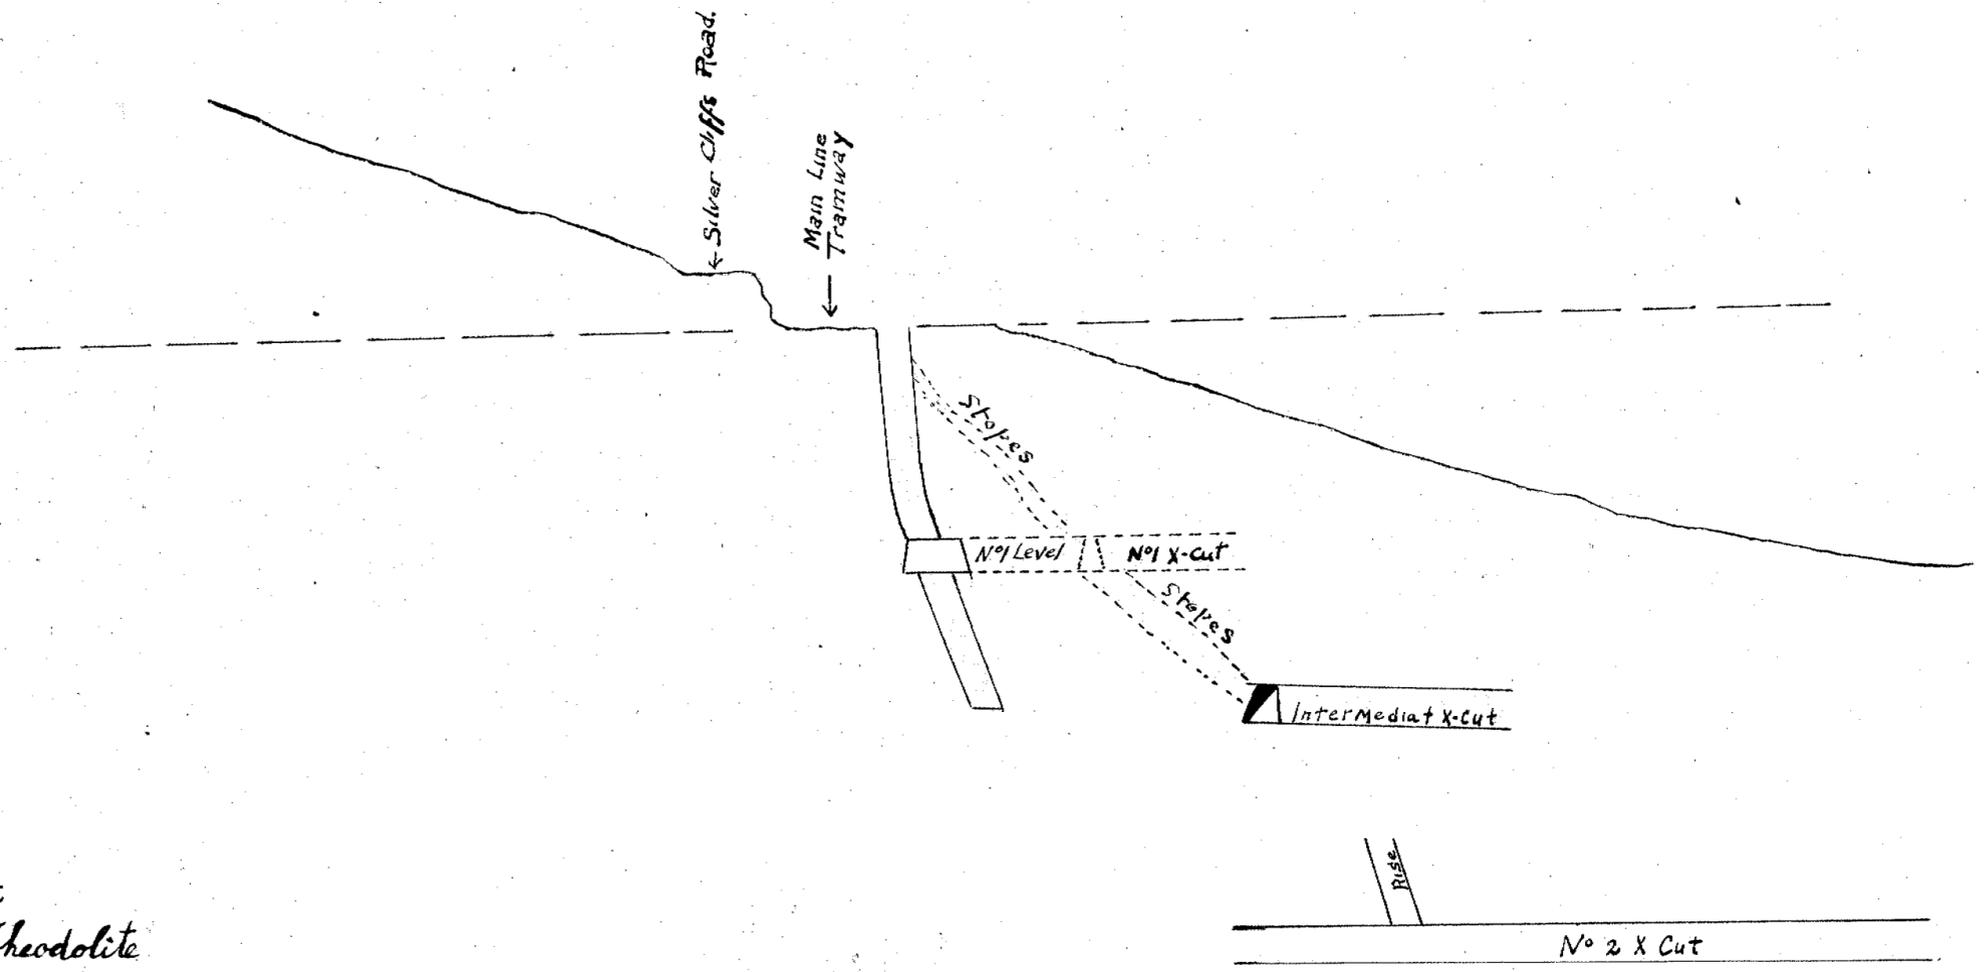

Work 1933
Surveyor W. H. Dorte
Instrument used 5" Theodolite