

MT BISCHOFF T. M. CO. REG.

THOMPSON LODE



LONGITUDINAL SECTION

SCALE 25 FT TO 1 INCH

50m

217247

TRANSVERSE SECTION

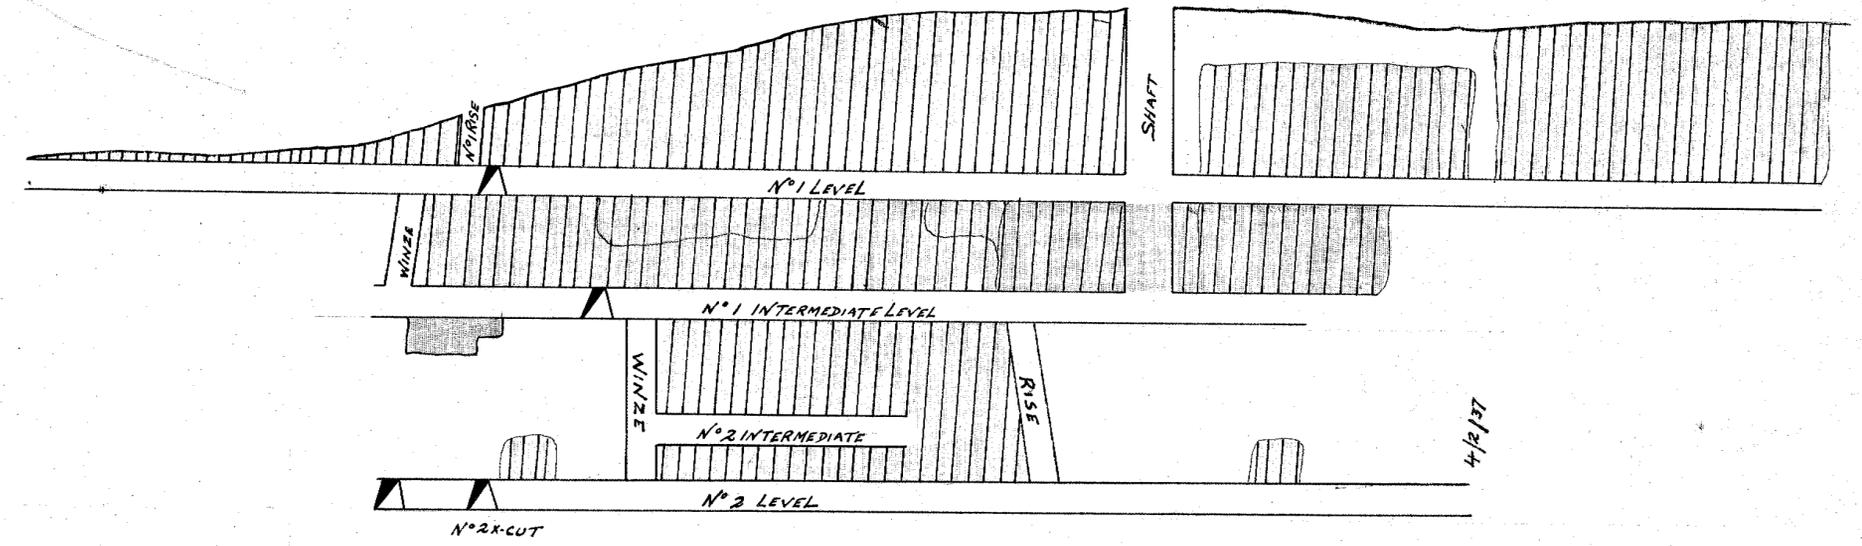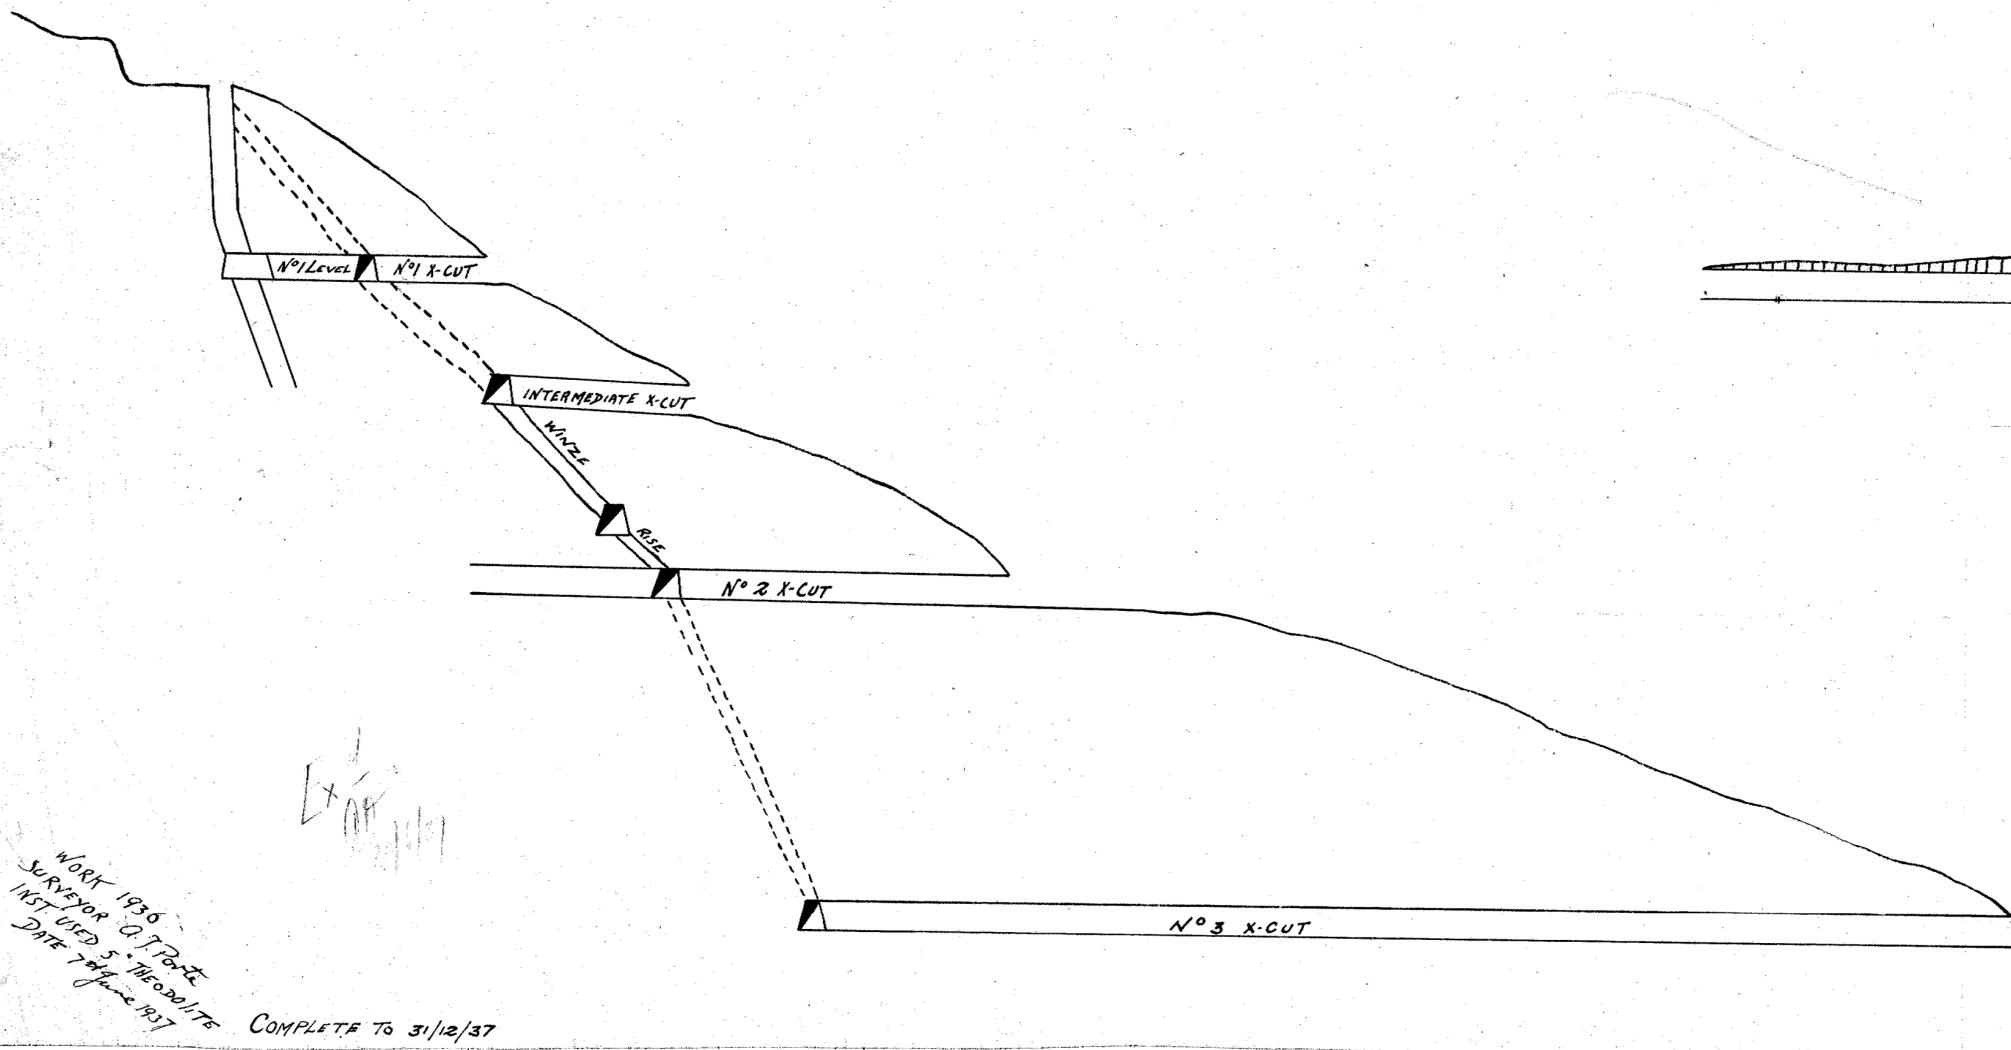

N°3 X-CUT

WORK 1936  
SURVEYOR O. J. TRAPE  
INST. USED 5" THEODOLITE  
DATE 7/14/37  
COMPLETE TO 31/12/37

217247